

HANCOCK
G 109
6-29-74

MISSISSIPPI
 BOARD OF WATER COMMISSIONERS
 416 North State Street
 Jackson, Mississippi 39201

WATER WELL DRILLERS LOG

CODED

6-29-74 date well completed
 Ward Well Drilling firm name
 Hancock county well located

LANDOWNER: Herbert Ayers
Box 301
Pass Christian, Miss.
 (mailing address)

description of formations encountered	from	to
top soil - clay	0	17
sd	17	32
clay	32	61
sd	61	78
clay	78	115
sd	115	167
clay - silt	167	245
sd	245	285

WELL LOCATION:
 sec. 18 T. 7 N. R. 14 E.
4 miles N/E of Wau, Miss.
 (distance) (direction) (nearest town)

WELL PURPOSE: Home
 (home, irrigation, municipal, industrial)

WELL COMPLETION DATA:

(1) diameter (inches) 2"

(2) total depth (feet) 285

(3) static water level (feet) 52 ^{below} above top of ground.

(4) casing 2" PVC, 2.75'
 (material) (depth)
 (size) If telescope see back.

(5) screen 10' 2"
 (length) (depth to top) (size) SCH. 80 PVC
 (material)

(6) pump 1 7
 (HP) (yield gpm)
etc.
 (type power)

(7) electric log no
 (yes or no)
N/A
 (organization running log)

(8) how well bottom plugged BWU


CODED

REGISTERED
 AUG - 1 1974

DRILLERS REMARKS: N/A

If well telescopes please sketch and show depths.

GROUND LEVEL

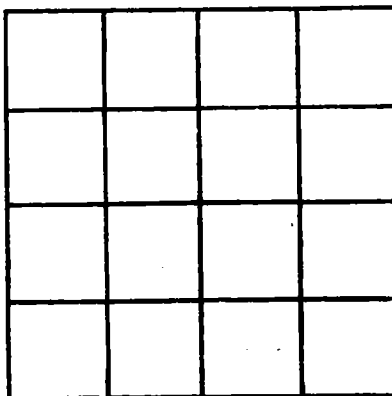

SECTION 18

Please indicate well location X.

ADDITIONAL INFORMATION

If more than one screen, show locations of each on sketch.