

**Handcock**  
**G 110**  
**5-31-74**

MISSISSIPPI  
 BOARD OF WATER COMMISSIONERS  
 416 North State Street  
 Jackson, Mississippi 39201

**CODED**

**WATER WELL DRILLERS LOG**

5-31 1974 Bud Penton & son Handcock  
 date well completed firm name county well located

LANDOWNER: Pat Kamenan  
Kiln Miss.

description of formations encountered	from	to
<u>Grey shale</u>	<u>0</u>	<u>41</u>
<u>White sand</u>	<u>41</u>	<u>190</u>
<u>Blue shale</u>	<u>190</u>	<u>460</u>
<u>Blue sand</u>	<u>460</u>	<u>557</u>
<u>Blue shale</u>	<u>557</u>	<u>780</u>
<u>Grey sand &amp; rock</u>	<u>780</u>	<u>870</u>
<u>Blue shale</u>	<u>870</u>	<u>1306</u>
<u>Grey sand</u>	<u>1306</u>	<u>1374</u>

(mailing address)

WELL LOCATION:

sec 19 T 7 N R 14 E  
 $\frac{1}{2}$  miles E of Kiln  
 (distance) (direction) (nearest town)

WELL PURPOSE: Home  
 (home, irrigation, municipal, industrial)

WELL COMPLETION DATA:

- (1) diameter (inches) 2 in
- (2) total depth (feet) 1374
- (3) static water level (feet) 33 1/2 below top of ground
- (4) casing Galv. 1354  
 (material) (depth)
- (size) if telescope see back.
- (5) screen 2x20 1354  
 (length) (depth to top)  
2x20 Steel 10/12  
 (size) (material)
- (6) pump No   
 (HP) (yield gpm)  
No  
 (type power)
- (7) electric log No  
 (yes or no)

**CODED**

(organization running log)


(8) how well bottom plugged Sand shale

DRILLERS REMARKS:

**REGISTERED**  
**001 - 8 1974**

If well telescopes please sketch and show depths.

GROUND LEVEL

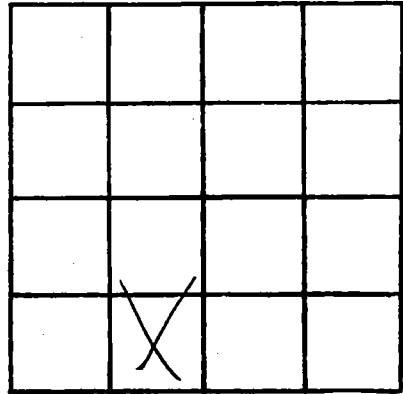

SECTION \_\_\_\_\_

Please indicate well location X.

ADDITIONAL INFORMATION

If more than one screen,  
show locations of each on sketch.