

**HANCOCK**  
 G 113  
 11-18-74

MISSISSIPPI  
 BOARD OF WATER COMMISSIONERS  
 416 North State Street  
 Jackson, Mississippi 39201

CODED

WATER WELL DRILLERS LOG

11-18 1974 Ward Well Drilling Hancock  
 date well completed firm name county well located

LANDOWNER: J.C. Koene  
Fire Tower Rd.  
Bay St. Louis, Miss.  
 (mailing address)  
 WELL LOCATION:  
 sec. 10 T. 7 N R. 18 E  
12 miles N/E of Bay St. Louis  
 (distance) (direction) (nearest town)

description of formations encountered	from	to
sandy - clay	0	21
sd	21	36
clay	36	52
sd	52	57
clay - silt	57	106
sd	106	121
clay	121	273
sd	273	280
clay	280	301
sd	301	325

WELL PURPOSE: Home  
 (home, irrigation, municipal, industrial)

WELL COMPLETION DATA:  
 (1) diameter (inches) 2"  
 (2) total depth (feet) 325  
 (3) static water level (feet) 37 below above top of ground.  
 (4) casing Galv., 315.  
 (material) (depth)  
 (size) If telescope see back.  
 (5) screen 10', -  
 (length) (depth to top)  
2", S.S.  
 (size) (material)  
 (6) pump 1, 8  
 (HP) (yield gpm)  
Elec.  
 (type power)  
 (7) electric log NO  
 (yes or no)  
N/A  
 (organization running log)  
 (8) how well bottom plugged BWU

CODED


RECORDED  
 DEC 17 1974

DRILLERS REMARKS: N/A

MISS. BD. OF WATER COMM.

If well telescopes please sketch and show depths.

GROUND LEVEL

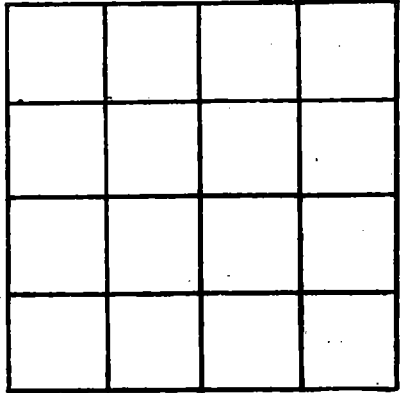

SECTION 10

Please indicate well location X.

ADDITIONAL INFORMATION

If more than one screen, show locations of each on sketch.