

**HANCOCK**  
**G 114**  
**12-27-74**

MISSISSIPPI  
 BOARD OF WATER COMMISSIONERS  
 416 North State Street  
 Jackson, Mississippi 39201

CODED

WATER WELL DRILLERS LOG

12/22 1974 McCall Well Work Hancock  
 date well completed firm name county well located

LANDOWNER: Association  
Church (convent)  
P.O. Box 97 Kiln, Miss  
 (mailing address)  
 WELL LOCATION:  
 sec 38 T 7 N R 14 E  
1/2 miles East of Kiln  
 (distance) (direction) (nearest town)


description of formations encountered	from	to
Clay	0	21
sand	21	30
Clay	35	72
sand	72	105
Clay	105	126
mud	126	168
Sand	168	272

WELL PURPOSE: Home  
 (home, irrigation, municipal, industrial)

WELL COMPLETION DATA:  
 (1) diameter (inches) 2 1/4  
 (2) total depth (feet) 272  
 (3) static water level (feet) 4' below top of ground  
 (4) casing Galv. 2 1/2" (material) 262' (depth)  
 (size) If telescope see back.  
 (5) screen 10" (length) 262' (depth to top)  
2" (size) SS (material)  
 (6) pump 1/2 (HP) 10 (yield gpm)  
Electric (type power)  
 (7) electric log no (yes or no)  
 (organization running log)

(8) how well bottom plugged Lead shot & back wash valve  
 DRILLERS REMARKS:

CODED

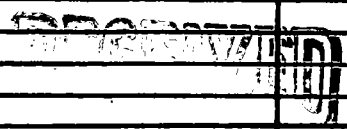


JAN 21 1975

COMM

If well telescopes please sketch and show depths.

GROUND LEVEL

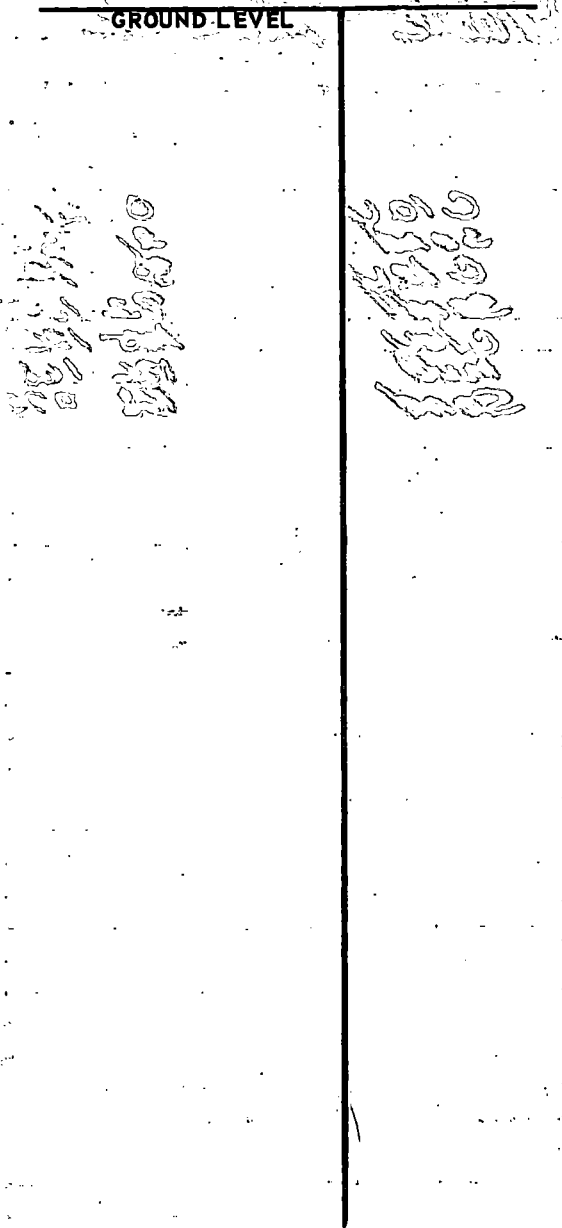

	X		

SECTION 38

Please indicate well location X.

ADDITIONAL INFORMATION

Handwritten notes and sketches in the 'ADDITIONAL INFORMATION' section. The notes are written in black ink on a series of horizontal lines. There are several lines of text, some with small sketches or symbols. The handwriting is somewhat cursive and difficult to read in some places. There are also some small diagrams or symbols drawn in the margins of the lines.

If more than one screen, show locations of each on sketch.