

HANCOCK
G 15
12-31-74

MISSISSIPPI
 BOARD OF WATER COMMISSIONERS
 416 North State Street
 Jackson, Mississippi 39201

CODED

WATER WELL DRILLERS LOG

Dec. 3
 date well completed

1974 McGill Well Works
 firm name

Hancock
 county well located

LANDOWNER: <u>Fred Curet Sr.</u>	description of formations encountered	from	to
<u>Kiln, Miss 39556</u> (mailing address)	<u>clay</u>	<u>0</u>	<u>21</u>
WELL LOCATION: sec. <u>34</u> T. <u>7</u> N. R. <u>14</u> E. <u>1 1/2</u> miles <u>East</u> of <u>Kiln</u> (distance) (direction) (nearest town)	<u>mlt</u>	<u>21</u>	<u>22</u>
WELL PURPOSE: <u>Domestic</u> (home, irrigation, municipal, industrial)	<u>clay</u>	<u>42</u>	<u>63</u>
WELL COMPLETION DATA: (1) diameter (inches) <u>2 1/2</u>	<u>sand</u>	<u>63</u>	<u>84</u>
(2) total depth (feet) <u>222'</u>	<u>mlt</u>	<u>84</u>	<u>168</u>
(3) static water level (feet) <u>41'</u> <u>below</u> above top of ground.	<u>sand</u>	<u>168</u>	<u>222</u>
(4) casing <u>2" PVC</u> , <u>262'</u> (material) (depth)			
(5) screen <u>10'</u> , <u>262'</u> (length) (depth to top)			
<u>2"</u> , <u>S.S.</u> (size) (material)			
(6) pump <u>1/2</u> , <u>10</u> (HP) (yield gpm)			
<u>Electric</u> (type power)			
(7) electric log <u>NO</u> (yes or no)			
(8) how well bottom plugged <u>partially</u> <u>and backwash valve</u>			
DRILLERS REMARKS:			


CODED

REGISTERED

JAN 21 1975

If well telescopes please sketch and show depths.

GROUND LEVEL

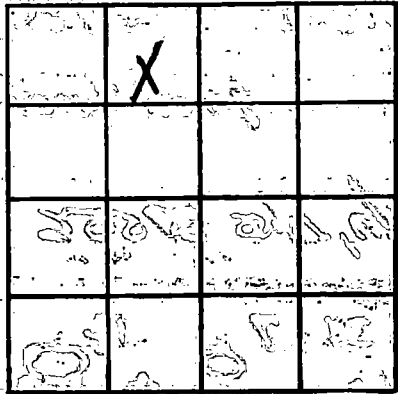

SECTION 38

Please indicate well location X.

ADDITIONAL INFORMATION

If more than one screen, show locations of each on sketch.