

HANCOCK
G 117
8-8-74

MISSISSIPPI
BOARD OF WATER COMMISSIONERS
416 North State Street
Jackson, Mississippi 39201

CODED
HANCOCK

WATER WELL DRILLERS LOG

8-8 1974 East Penton well serv. Pearl River
date well completed firm name county well located

LANDOWNER:
E. A. Allen
Bay St. Louis
(mailing address)

WELL LOCATION:
sec. 24 T 7 N R 14 E 13 5
1.0 miles N-E of Bay St. Louis
(distance) (direction) (nearest town)

WELL PURPOSE:
(home, irrigation, municipal, industrial)

WELL COMPLETION DATA:

(1) diameter (inches) 4.5

(2) total depth (feet) 135

(3) static water level (feet) 8 below top of ground

(4) casing P.V.C. 130
(material) (depth)

(5) screen 5 135
(length) (depth to top)

2" P.V.C.
(size) (material)

(6) pump 1/2 350 P.H.
(HP) (yield gpm)

Elect.
(type power)

(7) electric log NO
(yes or no)

(organization running log)

(8) how well bottom plugged shoe


description of formations encountered	from	to
Blue & white clay	0	16
Brown clay	16	32
Blue clay	32	70
Brown sd.	70	80
Blue clay	80	112
medium white sd.	112	135

CODED

DRILLERS REMARKS:
FEB 18 1975

If well telescopes please sketch and show depths.

GROUND LEVEL

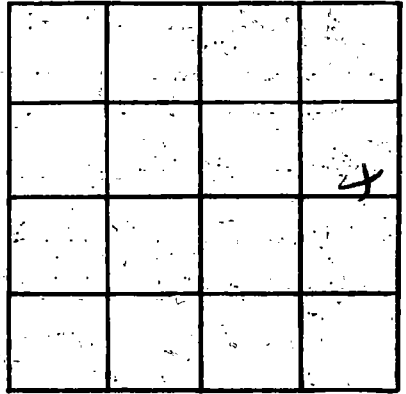

SECTION 24

Please indicate well location X.

ADDITIONAL INFORMATION

If more than one screen, show locations of each on sketch.