

HANCOCK
G 119
3-10-75

MISSISSIPPI
 BOARD OF WATER COMMISSIONERS
 416 North State Street
 Jackson, Mississippi 39201

CODED

WATER WELL DRILLERS LOG

3-10-75 date well completed 1975 Ward Well Drilling firm name Hancock county well located

LANDOWNER: W.A. Kenner
5th St.
Bay St. Louis, Miss.
 (mailing address)

description of formations encountered	from	to
clay	0	20
sd	20	55
grey clay	55	96
sd	96	122

WELL LOCATION:
 sec. 28 T. 3 N. R. 14 E.
7 miles N/W of B.S.L.
 (distance) (direction) (nearest town)

WELL PURPOSE: Home
 (home, irrigation, municipal, industrial)

WELL COMPLETION DATA:

(1) diameter (inches) 2"

(2) total depth (feet) 122 ft.

(3) static water level (feet) 2 below top of ground

(4) casing PVC, 117,
 (material) (depth)
 (size) If telescope see back.

(5) screen 5', -
 (length) (depth to top).
2", PVC
 (size) (material)

(6) pump -, -
 (HP) (yield gpm)
 (type power)

(7) electric log NO
 (yes or no)
N/A
 (organization running log)

(8) how well bottom plugged BWU

CODED


RECEIVED
 APR 2 1975

DRILLERS REMARKS: N/A

MISS. BD. OF WATER COMM

If well telescopes please sketch and show depths.

GROUND LEVEL

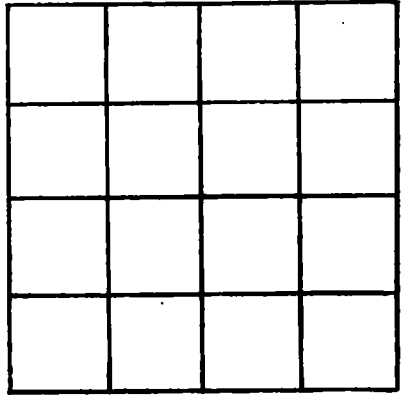

SECTION 28

Please indicate well location X.

ADDITIONAL INFORMATION

If more than one screen, show locations of each on sketch.