

Hancock
G/20
3-17-75

MISSISSIPPI
BOARD OF WATER COMMISSIONERS CODED
416 North State Street
Jackson, Mississippi 39201

WATER WELL DRILLERS LOG

3-17-1975 date well completed
Wood Well Drilling firm name
Hancock county well located

LANDOWNER: C.J. Sadner
Foster Rd
Kiln, Miss.
(mailing address)

description of formations encountered	from	to
Top Soil Layer	0	25
Sd	25	37
Clay - Silt	37	275
Coarse Sd	275	310

WELL LOCATION:
sec. 12 T 7 N R 10 E
2 1/2 miles N of Kiln
(distance) (direction) (nearest town)

WELL PURPOSE: Home
(home, irrigation, municipal, industrial)

WELL COMPLETION DATA:

(1) diameter (inches) 2"

(2) total depth (feet) 310

(3) static water level (feet) 41 ^{below} top of ground

(4) casing (material) PVC (depth) 300'
If telescope see back.

(5) screen (length) 10' (depth to top) -
(size) 2" (material) PVC

(6) pump (HP) 1 (yield gpm) 9
Elec. (type power)

(7) electric log NO (yes or no)
N/A (organization running log)

(8) how well bottom plugged BWV


DRILLERS REMARKS: N/A

CODED



If well telescopes please sketch and show depths.

GROUND LEVEL

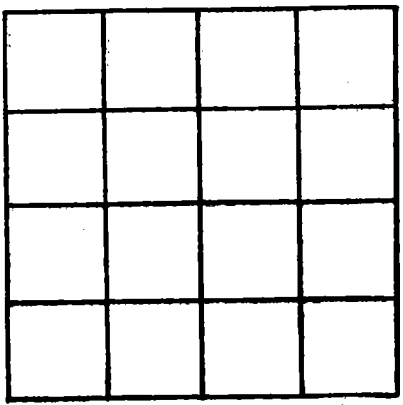

SECTION 12

Please indicate well location X.

ADDITIONAL INFORMATION

If more than one screen, show locations of each on sketch.