

**HANCOCK**  
**G 121**  
**4-9-75**

MISSISSIPPI  
 BOARD OF WATER COMMISSIONERS  
 416 North State Street  
 Jackson, Mississippi 39201

**CODED**

**WATER WELL DRILLERS LOG**

4-9-1975 Wood Well Drilling Hancock  
 date well completed firm name county well located

LANDOWNER: Wilson Purfait  
Cook St.  
Bay St. Louis miss.  
 (mailing address)

description of formations encountered	from	to
<u>fill clay</u>	<u>0</u>	<u>28</u>
<u>sc</u>	<u>28</u>	<u>37</u>
<u>clay</u>	<u>37</u>	<u>81</u>
<u>sd</u>	<u>81</u>	<u>96</u>
<u>Silt clay</u>	<u>96</u>	<u>355</u>
<u>SD</u>	<u>355</u>	<u>370</u>

WELL LOCATION:  
 sec 39 T 7 N R 14 E  
10 miles N/E of B.S.L.  
 (distance) (direction) (nearest town)

WELL PURPOSE: None  
 (home, irrigation, municipal, industrial)


- WELL COMPLETION DATA:
- (1) diameter (inches) 2"
  - (2) total depth (feet) 370
  - (3) static water level (feet) 3 below above top of ground.
  - (4) casing PVC 360  
 (material) (depth)  
— If telescope see back.  
 (size)
  - (5) screen 10' —  
 (length) (depth to top)  
2" PVC  
 (size) (material)
  - (6) pump — —  
 (HP) (yield gpm)  
—  
 (type power)
  - (7) electric log NO  
 (yes or no)  
N/A  
 (organization running log)
  - (8) how well bottom plugged BWD

DRILLERS REMARKS: N/A

**REGISTERED**  
**WELL DRILLER**  
**W. J. ...**  
**MAY 10 1975**

If well telescopes please sketch and show depths.

GROUND LEVEL

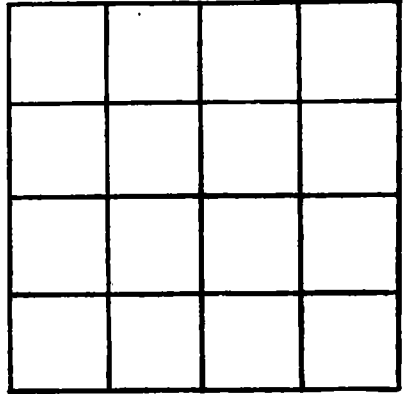

SECTION 39

Please indicate well location X.

ADDITIONAL INFORMATION

If more than one screen, show locations of each on sketch.