

Copy
 Hancock
 G 125
 12/5/74
 12/5/74


MISSISSIPPI
 BOARD OF WATER COMMISSIONERS
 416 North State Street
 Jackson, Mississippi 39201

CODED

WATER WELL DRILLERS LOG

1974 Prinville Waterworks Hancock
 date well completed firm name county well located

LANDOWNER: <u>Levi Facent</u>	description of formations encountered	from	to
<u>Levi Crep area</u>			
<u>Hahn Miss</u> (mailing address)	<u>lime clay</u>	<u>0</u>	<u>290</u>
WELL LOCATION: sec. <u>21 T 2 S R 14 E</u> <u>135</u> <u>1 1/2</u> miles <u>East</u> of <u>Hahn</u> (distance) (direction) (nearest town)	<u>Water sand</u>	<u>290</u>	<u>300</u>
WELL PURPOSE: <u>home</u> (home, irrigation, municipal, industrial)	<u>blue pipe clay</u>	<u>300</u>	<u>520</u>
WELL COMPLETION DATA: (1) diameter (inches) <u>2"</u>	<u>60 ft core</u>	<u>520</u>	<u>680</u>
(2) total depth (feet) <u>630</u>	<u>blue water sand</u>		
(3) static water level (feet) <u>20</u> ^{below} above top of ground.	<u>& small gravel</u>		
(4) casing <u>4" x 10'</u> <u>610</u> (material) (depth)			
<u>2"</u> (size) If telescope see back.			
(5) screen <u>20'</u> <u>610</u> (length) (depth to top)			
<u>2</u> (size) <u>PVC</u> (material)			
(6) pump <u>NA</u> <u>NA</u> (type) (yield gpm)			
<u>NA</u> (type power)			
(7) electric log <u>NA</u> (yes or no)			
<u>NA</u> (organization running log)			
(8) how well bottom plugged <u>sand</u> <u>flush</u>			

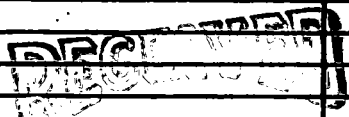

JUN 30 1975

DRILLERS REMARKS: farm's
home w/ out pump
free flow app 175 gpm

MISS. BD. OF WATER COMM

