

Hancock  
G 126  
5-7-75

MISSISSIPPI  
BOARD OF WATER COMMISSIONERS  
416 North State Street  
Jackson, Mississippi 39201

CODED

WATER WELL DRILLERS LOG

5-17-75 25 Woodwell Hancock  
date well completed firm name county well located

LANDOWNER: Don Joachim  
General Delivery  
Kiln, Miss.  
(mailing address)

description of formations encountered	from	to
	Topsoil - clay	0
sd	22	45
dry clay	45	97
sd - silt	97	121
clay - silt	121	328
sd - coarse	328	355

WELL LOCATION:  
sec. 15 T. 7 N. R. 14 E. 13S  
10 miles N/E of Kiln  
(distance) (direction) (nearest town)

WELL PURPOSE: Home  
(home, irrigation, municipal, industrial)


- WELL COMPLETION DATA:
- (1) diameter (inches) 2"
  - (2) total depth (feet) 355
  - (3) static water level (feet) 40 <sup>below</sup> top of ground
  - (4) casing PVC, 145'  
(material) (depth)  
- (size) if telescope see back.
  - (5) screen 10'  
(length) (depth to top)  
2" PVC  
(size) (material)
  - (6) pump 1 HP, 9 (yield gpm)  
Elec.  
(type power)
  - (7) electric log NO  
(yes or no)  
N/A  
(organization running log)
  - (8) how well bottom plugged BWU

DRILLERS REMARKS: N/A

MISSISSIPPI BOARD OF WATER COMMISSIONERS  
JACKSON, MISSISSIPPI 39201  
8 1975

If well telescopes please sketch and show depths.

GROUND LEVEL

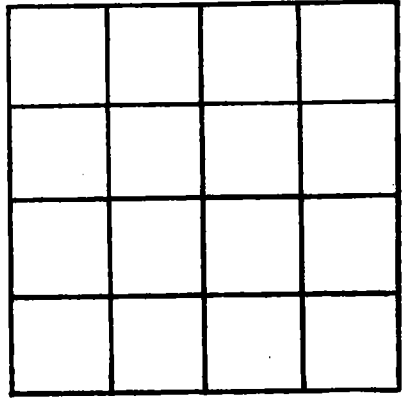

SECTION 15

Please indicate well location X.

ADDITIONAL INFORMATION

If more than one screen, show locations of each on sketch.