

Hancock
G 127
6-5-75

MISSISSIPPI
 BOARD OF WATER COMMISSIONERS
 416 North State Street
 Jackson, Mississippi 39201

CODED

WATER WELL DRILLERS LOG

6-5-75 19 ward well drilling Hancock
 date well completed firm name county well located

LANDOWNER: E. S. Miller
First St.
Bay St. Zions mine
 (mailing address)

description of formations encountered	from	to
<u>fill - clay</u>	<u>0</u>	<u>16</u>
<u>sd</u>	<u>16</u>	<u>46</u>
<u>clay</u>	<u>46</u>	<u>95</u>
<u>fine sandy</u>	<u>95</u>	<u>117</u>
<u>clay - silt</u>	<u>117</u>	<u>186</u>
<u>sd</u>	<u>186</u>	<u>205</u>

WELL LOCATION:
 sec. 28 T 8 N R. 14 E 13S
7 miles n/w of B. Lake
 (distance) (direction) (nearest town)

WELL PURPOSE: 17 min
 (home, irrigation, municipal, industrial)


- WELL COMPLETION DATA:
- (1) diameter (inches) 2"
 - (2) total depth (feet) 205
 - (3) static water level (feet) 2 60 above top of ground
 - (4) casing DUC, 200,
 (material) (depth)
— If telescope see back.
 (size)
 - (5) screen 5', —
 (length) (depth to top)
2", DUC
 (size) (material)
 - (6) pump —, —
 (HP) (yield gpm)
—
 (type power)
 - (7) electric log NO
 (yes or no)
N/A
 (organization running log)
 - (8) how well bottom plugged BWU

DRILLERS REMARKS: N/A

MISSISSIPPI
 BOARD OF WATER COMMISSIONERS
 JUNE 1975

If well telescopes please sketch and show depths.

GROUND LEVEL

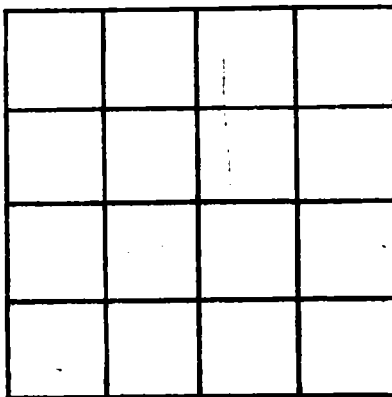

SECTION 2

Please indicate well location X.

ADDITIONAL INFORMATION

A series of horizontal lines for writing additional information, starting below the 'ADDITIONAL INFORMATION' header.

If more than one screen, show locations of each on sketch.