

G 131

CODED

10-28-65

135

WATER WELL DRILLERS LOG

Date: 10-28, 1965, Driller: Sutton Well Works, Hancock

(Name)

(1) Owner of Land: Izella French  
(Name)  
Pass Christian, Miss  
(Address)

(2) Location: NE 1/4, NW 1/4, Sec 25 T 25R 14 S  
1 1/2 miles SE of Fenton  
(distance) (direction) (Nearest Town)

(3) Topography: Hilly  
(Hilly) (Flat) (Level)

(4) Purpose of Well: domestic  
(Domestic Irrigation  
Municipal, Industrial, Other)

Description & Color of Materials Sand, Clay, Red Clay, Shell, etc.	Thick- ness Feet	Depth Feet
Clay	6	6
sandy clay	122	128
Sand	32	160
Clay	12	172
Sand	42	214
Clay	103	317
Sand	60	377
Clay	11	388
Sand	34	422
CODED Clay	92	514
Sand	107	621
Clay	17	638
Sand	57	695

Information upon completion of well:

(1) Diameter 2 inches.

(2) Total Depth 695 feet.

(3) Water Level + 26 feet above ground.

(4) Cased to all, Size 2"

(5) Screen: Size 2", Length 16'


(6) Were any formations sealed against pollution?

yes, no. [checked]

If YES depth of formation

Why

Drillers Remarks:

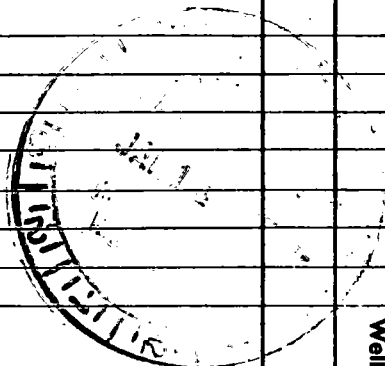

(Use Back Side)

Well No.

