

Hancock
G 132
12-66

MISSISSIPPI
BOARD OF WATER COMMISSIONERS
416 North State Street
135 Jackson, Mississippi 39201

CODED

WATER WELL DRILLERS LOG

12-20 1966 SUTTER WELL WORKS Hancock
date well completed firm name county well located

LANDOWNER: JOHN KISTLER

KILN, Miss.

(mailing address)

WELL LOCATION:

sec. 38 T. 7 S. R. 14 W.
1 miles E of KILN
(distance) (direction) (nearest town)

WELL PURPOSE: Home
(home, irrigation, municipal, industrial)

WELL COMPLETION DATA:


- (1) diameter (inches) 2
- (2) total depth (feet) 397
- (3) static water level (feet) 16 ^{inches} above top of ground.
- (4) casing GALV. 397
(material) (depth)
2" (size) if telescope see back.
- (5) screen 15' 382'
(length) (depth to top)
2" (size) S.S. (material)
- (6) pump UNKNOWN
(HP) (yield gpm)
- (type power)
- (7) electric log No
(yes or no)
- (organization running log)
- (8) how well bottom plugged B.P. VALVE

description of formations encountered

from to

SAND	0	20
CLAY	20	82
SAND	82	142
CLAY	142	191
SAND	191	260
CLAY	260	360
SAND	360	397

CODED

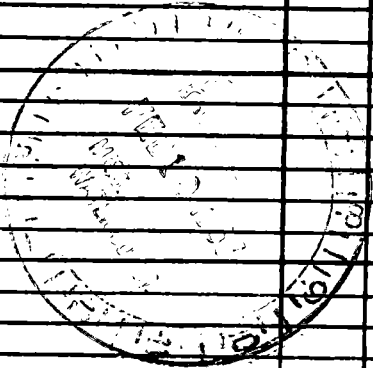

DRILLERS REMARKS:

If well telescopes please sketch and show depths.

GROUND LEVEL



X			

SECTION 38

Please indicate well location X.

ADDITIONAL INFORMATION

If more than one screen, show locations of each on sketch.