

Hancock  
G133  
9-67

MISSISSIPPI  
 BOARD OF WATER COMMISSIONERS  
 416 North State Street  
 Jackson, Mississippi 39201

CODED

WATER WELL DRILLERS LOG

9-5 1967 SUTTER WELL WORKS Hancock  
 date well completed firm name county well located

LANDOWNER: RANDALL MAUFERAY  
RT. 1 Box 134  
Pass Christian Miss  
 (mailing address)


description of formations encountered	from	to
Clay	0	22
Sand	22	35
Clay	35	110
Sand	110	140
Clay	140	182
Sand	182	228
Clay	228	340
Sand	340	667

WELL LOCATION:  
 sec. 24 T. 7 S. R. 14 E.  
3 miles E of Fanton  
 (distance) (direction) (nearest town)

WELL PURPOSE: home  
 (home, irrigation, municipal, industrial)

CODED

- WELL COMPLETION DATA:
- (1) diameter (inches) 2
  - (2) total depth (feet) 667
  - (3) static water level (feet) 24 <sup>below</sup> above top of ground.
  - (4) casing galv. 651'  
 (material) (depth)  
2"  
 (size) If telescope see back.
  - (5) screen 16' 651'  
 (length) (depth to top)  
2" stainless steel  
 (size) (material)
  - (6) pump none  
 (HP) (yield gpm)
  - (type power)
  - (7) electric log no  
 (yes or no)
  - (organization running log)
  - (8) how well bottom plugged BP Valve

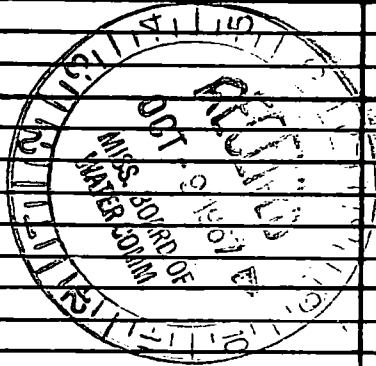

DRILLERS REMARKS:

If well telescopes please sketch and show depths.

GROUND LEVEL

			X

SECTION 24

Please indicate well location X.

ADDITIONAL INFORMATION

If more than one screen, show locations of each on sketch.