

Hancock
G137
9-18-68

MISSISSIPPI
 BOARD OF WATER COMMISSIONERS
 416 North State Street
 135 Jackson, Mississippi 39201 **CODED**
 WATER WELL DRILLERS LOG

9-18 1968 NEIL LUMPKIN WELL Hancock
 date well completed firm name county well located
DRILLING SERVICE

LANDOWNER: Mandy
Aukerwith
P.O. Box 82
Tiln, Miss.
 (mailing address)

description of formations encountered	from	to
Surface clay	0	10
" sand	10	30
Blue clay	30	110
Good sand	110	150
Blue clay	150	200
Good sand	200	250
Blue clay	250	400
Good sand	400	452

WELL LOCATION:
 sec. 30 T. 7 S. R. 14 W.
 (distance) (direction) (nearest town)

WELL PURPOSE: Home
 (home, irrigation, municipal, industrial)

WELL COMPLETION DATA:

(1) diameter (inches) 2

(2) total depth (feet) 452

(3) static water level (feet) 10 lbs ^{below} pressure ^{above} top of ground.

(4) casing black +23'
 (material) (depth)

2 1/2" if telescope see back.
 (size)

(5) screen 10' 452
 (length) (depth to top)

2"
 (size) (material)

(6) pump _____ (HP) _____ (yield gpm)


(type power) _____

(7) electric log No.
 (yes or no)

(organization running log) _____

(8) how well bottom plugged Johnson
BP Valve

CODED

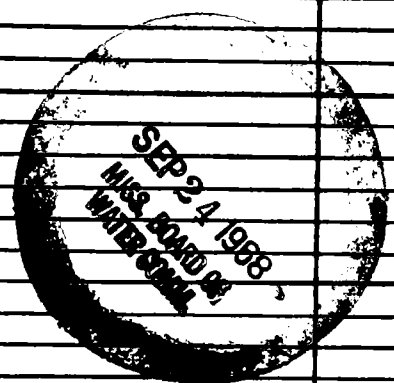

DRILLERS REMARKS:

If well telescopes please sketch and show depths.

GROUND LEVEL

X			

SECTION _____

Please indicate well location X.

ADDITIONAL INFORMATION

If more than one screen, show locations of each on sketch.