

HANCOCK
 #141
 5/80
 Log # 82

MISSISSIPPI
 BOARD OF WATER COMMISSIONERS
 416 North State Street
 Jackson, Mississippi 39201

CODED ✓

WATER WELL DRILLERS LOG

19 80 PRINER DRILLING SER. HANCOCK
 date well completed firm name county well located

LANDOWNER: KILN WATER
AND FIRE PROTECTION DISTRICT
 (mailing address)

description of formations encountered	from	to
Top soil	0	3
SAND	3	10
CLAY	10	90
SAND w/CLAY streaks	90	178
SAND	178	288
CLAY and thin SAND STR	288	490
SAND	490	646

WELL LOCATION: NE 1/4 SW 1/4 NW 1/4
 sec. 30 T 7 N R 14 E
 (S) (W)
 miles of (distance) (direction) of (nearest town)

WELL PURPOSE:
 (home, irrigation, municipal, industrial)

CODED

WELL COMPLETION DATA:

- (1) diameter (inches) 8 5/8
- (2) total depth (feet) 597'
- (3) static water level (feet) 10.39 below top of ground. above
- (4) casing Steel 547'
 (material) (depth)
8 5/8
 (size) If telescope see back.
- (5) screen 40 557'
 (length) (depth to top)
6" 304 S.S. (.008)
 (size) (material)
- (6) pump 15 200
 (HP) (yield gpm)
ELECT.
 (type power)
- (7) electric log Yes
 (yes or no)
MGS
 (organization running log)
- (8) how well bottom plugged BACK
WASH VALVE

DRILLERS REMARKS:


DEPT. OF NATURAL RESOURCES
 BUREAU OF LAND & WATER RESOURCES

JUN 9 1980

RECEIVED

If well telescopes please sketch and show depths.

GROUND LEVEL

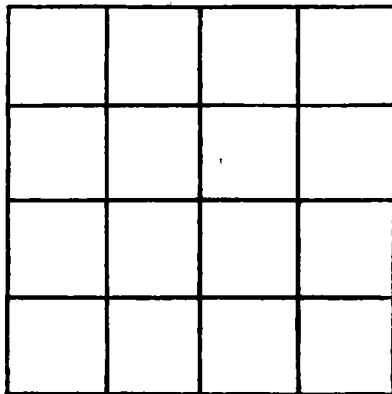

SECTION _____

Please indicate well location X.

ADDITIONAL INFORMATION

Lined area for additional information.

If more than one screen, show locations of each on sketch.