

HANCOCK  
 142  
 5-28-81

MISSISSIPPI  
 BOARD OF WATER COMMISSIONERS  
 416 North State Street  
 Jackson, Mississippi 39201

**CODED**

WATER WELL DRILLERS LOG

5-28-1981 date well completed      Ward Well Pkg. firm name      Hancock county well located


LANDOWNER: Paul Finley  
 Rt. 4, Box 179  
 Bay St. Louis, ms.  
 (mailing address)

description of formations encountered	from	to
Fill - clay	0	27
sd	27	36
Clay - silt	36	165
fine sd	165	178
Clay - silt	178	380
sd - fine	380	410
Clay - silt	410	525
Red Street - sd	525	546

WELL LOCATION:  
 sec. 22 T. 8 N. R. 13 E. S. 7  
 8 miles N of Bay St. Louis  
 (distance) (direction) (nearest town)

WELL PURPOSE: Home  
 (home, irrigation, municipal, industrial)


- WELL COMPLETION DATA:
- (1) diameter (inches) 2"
  - (2) total depth (feet) 556
  - (3) static water level (feet) 10 <sup>below</sup> ~~above~~ top of ground.
  - (4) casing PUC (material), 546 (depth)
  - (size) If telescope see back.
  - (5) screen 10' (length), (depth to top)  
 2" (size), Stainless Steel (material)
  - (6) pump N/A (HP), (yield gpm)  
 (type power)
  - (7) electric log NO (yes or no)  
 N/A (organization running log)
  - (8) how well bottom plugged BWU

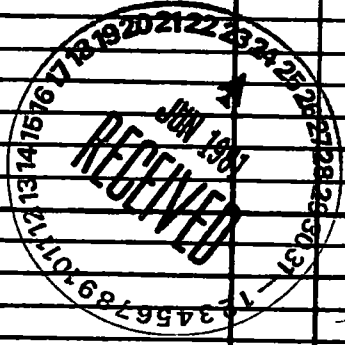

DRILLERS REMARKS: Will  
 showing approx. 2.0 G.P.M.  
 5 P.S.T.

If well telescopes please sketch and show depths.

GROUND LEVEL

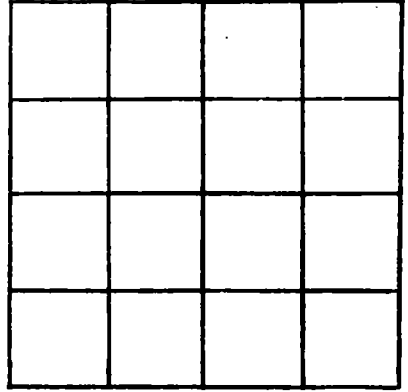

SECTION 22

Please indicate well location X.

ADDITIONAL INFORMATION

A series of horizontal lines for providing additional information, starting below the 'ADDITIONAL INFORMATION' header and extending to the bottom of the page.



If more than one screen, show locations of each on sketch.