

**MISSISSIPPI DEPARTMENT OF NATURAL RESOURCES**  
**Bureau of Land and Water Resources**  
 Southport Mall  
 P.O. Box 10631  
 Jackson, Mississippi 39209  
**WATER WELL DRILLERS LOG**

**HANCOCK**  
**6148**  
**3-20-85**

Mar. 20 1985 Ward Well Dg. Hancock  
 date well completed firm name county well located

**LANDOWNER:** Claude Pannemont  
Firetower Rd.  
Pass Christian ms.  
 (mailing address)

**WELL LOCATION:**  
 ? sec. 10 T. 7 N. R. 13 E. 4  
10 miles N/E of Bilbo  
 (distance) (direction) (nearest town)

**WELL PURPOSE:** Home  
 (home, irrigation, municipal, industrial)

- WELL COMPLETION DATA:**
- (1) diameter (inches) 4" x 2"
  - (2) total depth (feet) 420
  - (3) static water level (feet) 60 below top of ground.
  - (4) casing PVC, 400,  
 (material) (depth)  
 (size) If telescope see back.
  - (5) screen 20', -  
 (length) (depth to top)  
2", PVC  
 (size) (material)
  - (6) pump runner, -  
 (HP) (yield gpm)  
 (type power)
  - (7) electric log NO  
 (yes or no)  
N/A  
 (organization running log)
  - (8) how well bottom plugged BWD

description of formations encountered	from	to
<u>Clay</u>	<u>0</u>	<u>12</u>
<u>Sandy Clay</u>	<u>12</u>	<u>66</u>
<u>Clay - Silt</u>	<u>66</u>	<u>265</u>
<u>Fine sd</u>	<u>265</u>	<u>284</u>
<u>Clay - Silt</u>	<u>285</u>	<u>370</u>
<u>Coarse sd</u>	<u>370</u>	<u>426</u>

**DRILLERS REMARKS:** N/A

**RECEIVED**  
 MAY 14 1985  
 Department of Natural Resources  
 Bureau of Land & Water Resources

If well telescopes please sketch and show depths.


GROUND LEVEL

220' - Sch. 40.4" PVC Casing

200' - Sch. 40  
2" PVC Casing

20' - 2"  
PVC SCREEN

FIG. K. PAPER

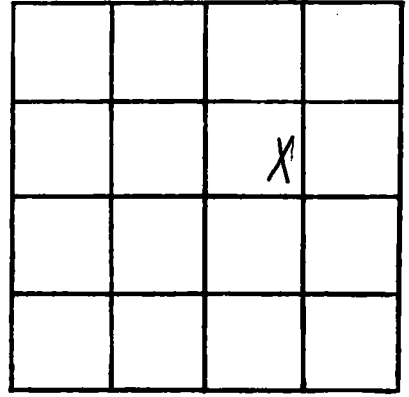

SECTION 10

Please indicate well location X.

ADDITIONAL INFORMATION

2" Casing sealed in 4" by Figure K Paper - 20' to 4"

If more than one screen, show locations of each on sketch.