

392 A01B

Hancock
G 150

MISSISSIPPI BOARD OF WATER COMMISSIONERS CODED

416 North State Street
Jackson, Mississippi 39201
Miss. License # - 0-207
WATER WELL DRILLERS LOG

Permit # MS-GW-11798

M.C. ANTHON
WATERWELL CONTRACTOR

Hancock

5-18-89
date well completed

Route 2, Box 1425
LACOMBE, LOUISIANA 70445

county well located

LANDOWNER: Ronald Mentel

description of formations encountered

from to

337 Marina Blvd

Clay

0 10

Mandeville La

Sand

10 35

504/845-7584 (mailing address)

WELL LOCATION: NE qtr 3, NE qtr 4

clay

35 100

2 sec 39 T 7 N S R 14 E W

Sand

100 125

(distance) miles (direction) of (nearest town)

Clay

125 140

WELL PURPOSE: Crampfish Pond
(home, irrigation, municipal, industrial)

Sand

140 180

WELL COMPLETION DATA:

(1) diameter (inches) 10"

clay

180 —

(2) total depth (feet) 180'

(3) static water level (feet) 10 above top of ground.

(4) casing PVC 105'
(material) (depth)

10" If telescope see back.
(size)

(5) screen 50' 105' & 145'
(length) (depth to top)

10" PVC
(size) (material)

(6) pump 5 150
(HP) (yield gpm)

Gasoline 30' drawdown
(type power)

(7) electric log No
(yes or no)

(organization running log)

(8) how well bottom plugged Backward
Value

RECEIVED



JUN 23 1989

Department of Natural Resources
Bureau of Land & Water Resources

DRILLERS REMARKS: 14" Dia.

Borehole - Travel Pack around
screens from -180' to -90'

If well telescopes please sketch and show depths.

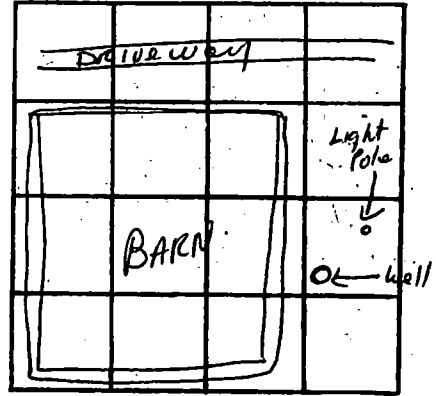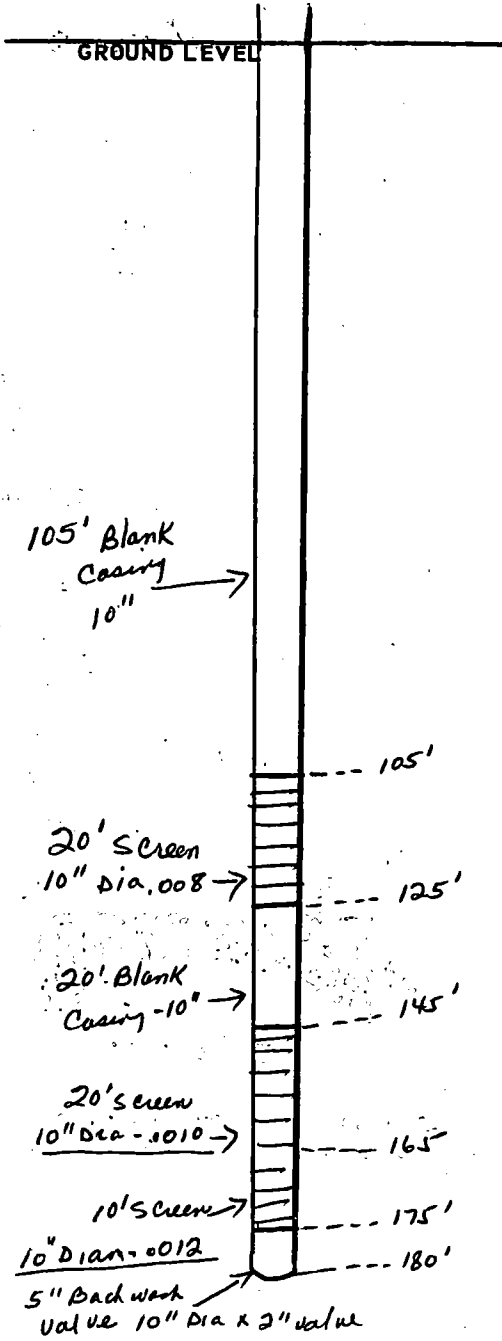

SECTION 39

Please indicate well location X.

ADDITIONAL INFORMATION

Gravel Pack around Screens to -90'
If more than one screen,
show locations of each on sketch.