

# STATE WELL REPORT

## Part 1

### Driller's Log

Mississippi Department of Environmental Quality  
Office of Land and Water Resources  
P.O. Box 2309  
Jackson, MS 39225-2309  
(601)961-5555  
(601)961-5228 (fax)

#### For Office Use Only:

Well #: G175  
Aquifer: \_\_\_\_\_  
E-Log #: \_\_\_\_\_

County: Hancock  
Permit #: 0239  
Driller: McMill Pump Well  
Date drilling completed: 4/14/09

*State Law requires that this report be prepared by the license holder responsible for the work and filed with the Department at the above address within 30 days of completion of drilling of the well or borehole.*

Well Owner Information <small>(Landowner if borehole is not for a water well)</small>	Well or Borehole Location
Owner Name: <u>David Drener</u>	Latitude: <u>30.419191</u> Longitude: <u>89.311402</u>
Mailing Address: <u>1000 Kin-Delise Rd</u>	Method of Lat/Long (check one): Conventional Survey _____, USGS quad _____, Hand-held GPS <u>0</u> , Survey-grade GPS _____
<u>Poss Christian, MS 39571</u> City State Zip Code	<u>NE</u> ¼ <u>SE</u> ¼, Sec <u>24</u> T <u>07S</u> R <u>14W</u>
Telephone No. <u>(228) 214-3689</u>	<u>3</u> Miles <u>SW</u> of <u>Diamondhead</u> (Distance) (Direction) (Nearest Town)

**Well / Borehole Data**

Date drilling started: \_\_\_\_\_ Date drilling completed: 4/14/09 Hole depth: 310 Hole diameter: 4x2

Location of the source of any surface water used for drilling: Waterwell

Method of dosing and volume of Chlorine used in drilling and development: N/A

Logs run (check all applicable):  log run  Electric  Gamma Ray  Density  Sonic  Neutron Other: No log run

Name of organization running log(s): N/A

Purpose of borehole (check one): Water Well  Geotechnical/Geological Investigation  Ground Source Heat Pump  Seismic Survey Other (describe) \_\_\_\_\_

*If drilling is not related to water well construction, skip the remainder of this block*

Purpose of Well (check all applicable):  Home  Industrial  Public Supply  Irrigation  Fish Culture

Other (describe): \_\_\_\_\_

If a flowing well, method of flow regulation: Valve \_\_\_\_\_ Other (describe) \_\_\_\_\_

Static Water Level: 306 <sup>30 ft</sup> feet  above or  below land surface Date measured: 4/14/09

Method of measurement (check one)  Steel tape  Electric tape  Air line  Other (describe): \_\_\_\_\_

Well depth: 310 Well grouted to a depth of: 10 feet Type of grout (check one)  Neat Cement  Bentonite  Mix

Casing length: 290 feet Casing diameter: 4x2 inches Type of casing: PVC

Screen length: 20 feet Screen diameter: 2 inches Type of screen: PVC

Screen slot size: .020 inches Setting depth: From 290 feet to 310 feet

Type of completion (check all applicable)  gravel packed  Underreamed  Open hole  Natural Development

Other (describe): \_\_\_\_\_

Top of lap pipe or reduction in casing: 200 feet

*If telescoped or more than one screen, describe on next page*


RECEIVED  
MAY 05 2021  
BY OLWR

County: Hancock  
 Permit #: 0234

**For Office Use Only:**  
 Well #: G175

The sketch below only required for water wells  
If well telescopes, show depths on sketch.

Description of formations encountered must be provided for all wells and boreholes, unless specifically exempted by regulations

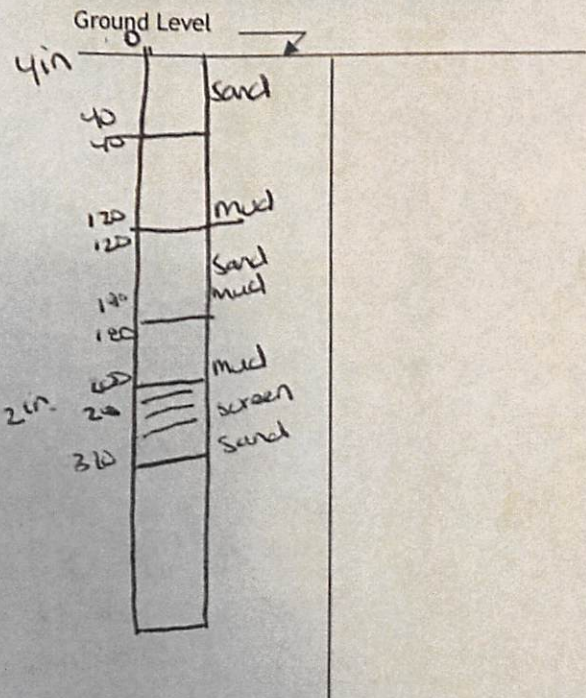


Description of Formations Encountered	From (depth) Ground level	To (depth)
Sand	0	40
mud	40	120
Sand / mud	120	180
mud	180	200
sand	200	310

RECEIVED  
 MAY 05 2021  
 BY OLWR

If more than one screen, show location of each on sketch

Sketch the property layout and include the following:

- 1) the well location
- 2) any permanent structures on the property that may aid in locating the well
- 3) any roads, power lines, or other items that may aid in locating the property and the well
- 4) north arrow

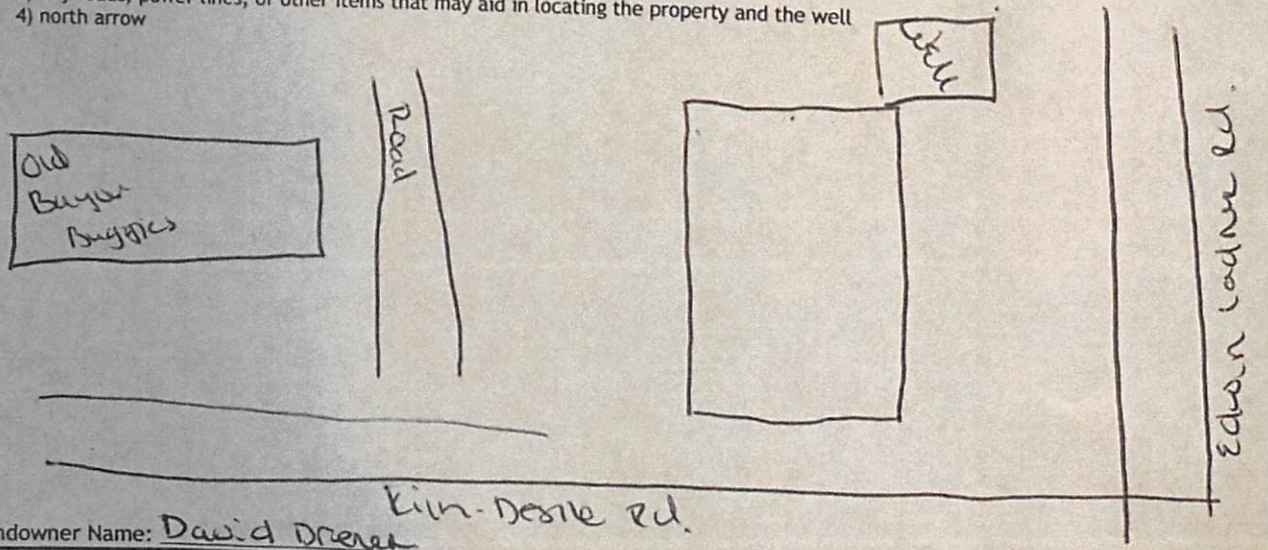

Landowner Name: David Drenth

I HEREBY CERTIFY that the well/borehole was drilled, constructed, and completed in accordance with all applicable requirements of the Mississippi Department of Environmental Quality and the Mississippi Department of Health regulations, if applicable, and state laws.

Michael Mann & #0234

Print Name of Responsible Licensee and License No.

11/1/09  
Date

Signature of Licensee

# STATE WELL REPORT

## Part 2

**Pump Installer's Completion Report**  
 Mississippi Department of Environmental Quality  
 Office of Land and Water Resources  
 P.O. Box 2309  
 Jackson, MS 39225-2309  
 (601)961-5210  
 (601) 360-0535 (fax)

County: Hancock  
 Permit #: 0234  
 Driller: Michael Pump Well  
 Date completed: 4/14/09  
*Copy information from block on Part 1*

**For Office Use Only:**  
 Well #: G175  
 Aquifer: \_\_\_\_\_

*This part of the report must be completed by a licensed water well contractor or a licensed pump installer. A copy of Part 1 of the report must be attached and both parts filed with the Department at the above address within 30 days of well completion.*

Well Owner Information	Well Location
Owner Name: <u>David Drener</u>	Latitude: <u>30.119191</u> Longitude: <u>89.341102</u>
Mailing Address: <u>1000 Kiln Delia Rd.</u>	Method of Lat/Long (check one): Conventional Survey _____, USGS quad _____, Hand-held GPS <u>0</u> , Survey-grade GPS _____
<u>Pascagoula, MS</u> <u>39571</u>	_____/_____/_____, Sec _____ T _____ R _____
City State Zip Code	<u>3</u> Miles <u>East</u> of <u>Diamondhead</u>
Telephone No. <u>(228) 210-3008</u>	(Distance) (Direction) (Nearest Town)

**Pump Type (check one)**

Submersible  Turbine  Air Lift  Centrifugal  Flowing Well  Jet  Piston  Rotary  Other (describe): \_\_\_\_\_

Date Pump Installed: 4/14/09 Rated Pump Capacity: 25 Gallons Per Minute

Is This Pump (check one):  New  Repaired  Replacement

**Power Type (check one)**

Electric  Diesel  Gasoline  Natural Gas  Tractor PTO  Windmill  Other (describe): \_\_\_\_\_

Horse Power Rating of Motor: 1/2 Setting Depth: 100 feet Number of Stages: 10

**Pump Test Data for Non Flowing Well**

Date Well Tested: 4/14/09 Duration of Pump Test (minimum 4 hours): 4 hours

Static Water Level (A): 30 Feet Below Land Surface Pumping Water Level (B): 30 Feet Below Land Surface

Drawdown [(B) - (A)]: 0 Feet Below Land Surface Test Pumping Rate: 25 Gallons Per Minute

Method of measurement (check one): Steel tape  Electric tape  Air line  Other (describe): \_\_\_\_\_

**Pump Test Data for Flowing Well**

Measured shut in head: \_\_\_\_\_ feet.

Well yielded \_\_\_\_\_ GPM with a drawdown of \_\_\_\_\_ feet after \_\_\_\_\_ hours of pumping

**Meter Installation** N/A

Meter Manufacturer: \_\_\_\_\_ Meter Serial Number: \_\_\_\_\_

Meter Model Number/Name: \_\_\_\_\_ Type of Meter: \_\_\_\_\_

Totalizer Register Unit and Multiplier Factor (AF x .001, gal x 1000, etc): \_\_\_\_\_

Installation Date: \_\_\_\_\_ Meter installed by: \_\_\_\_\_

Is This Meter (check one):  New  Repaired  Replacement

*Important: By submitting the above information you are certifying that this meter was installed to manufacturer standards. For agricultural wells, a list of approved meters is on the MDEQ website.*

I HEREBY CERTIFY that the above statements are true to the best of my knowledge.

Michael Mead Sr #0234 4/14/09 \_\_\_\_\_  
 Print Name of Pump Installer and License No. (if applicable) Date Signature of Pump Installer

RECEIVED  
 MAY 05 2021  
 BY OLWR