

G 2005
3-14-61

WATER WELL DRILLERS LOG G-312

Date: 3-14, 1961, Driller: Jetter Well Works County Hancock
(Name)

(1) Owner of Land: A. E. Abounga
(Name)
Rt. 1 Pass Christian, Miss.
(Address)

(2) Location: 1/4, 1/4, Sec. 28 ^{16SR11V}
6 miles NE, of Kilm
(distance) (direction) (Nearest Town)

(3) Topography: Hilly
(Hilly) (Flat) (Level)

(4) Purpose of Well: pond
(Domestic Irrigation
Municipal, Industrial, Other)

Description & Color of Materials Sand, Clay, Red Clay, Shell, etc.	Thick-ness Feet	Depth Feet
<u>Clay</u>	<u>40</u>	<u>40</u>
<u>Coarse sand</u>	<u>42</u>	<u>82</u>
<u>Blue clay - sand streaks</u>	<u>167</u>	<u>249</u>
<u>sand</u>	<u>63</u>	<u>312</u>

Information upon completion of well:

(1) Diameter 2 inches.

(2) Total Depth 312 feet.

(3) Water Level 7 feet ^{above} below top of ground.

(4) Cased to all, Size 2"


(5) Screen: Size 2", Length 15'

(6) Were any formations sealed against pollution?
10 gauge
no.

If YES depth of formation _____

Why _____

Drillers Remarks: _____

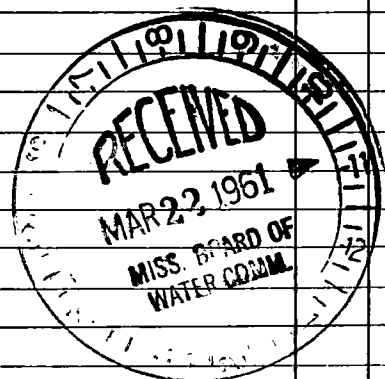

(Use Back Side)

Well No.

