

G 2006
6-14-61

WATER WELL DRILLERS LOG

G-304

Date: 6-14, 1961, Driller: Leno of Bull County Hancock
(Name)

(1) Owner of Land: HE Baltar
(Name)
430 Pers Road Hombro Miss
(Address)

(2) Location: 1/4, 1/4, Sec. 31 16 R HW
4 miles North of Kilmara
(distance) (direction) (Nearest Town)

(3) Topography: X
(Hilly) (Flat) (Level)

(4) Purpose of Well: Home use
(Domestic Irrigation
Municipal, Industrial, Other)

Description & Color of Materials Sand, Clay, Red Clay, Shell, etc.	Thick- ness Feet	Depth Feet
<u>White sand</u>	<u>60</u>	<u>60</u>
<u>Blue clay</u>	<u>166</u>	<u>226</u>
<u>stratified</u>	<u>60</u>	<u>286</u>
<u>total</u>		<u>286</u>
<u>total depth 286 ft</u>		

Information upon completion of well:

(1) Diameter 2 inches.

(2) Total Depth 286 feet.

(3) Water Level Flow 10 ft pressure feet below top of ground.

(4) Cased to 63, Size 4"


(5) Screen: Size 2", Length 18 ft

(6) Were any formations sealed against pollution?
Cement top of casing
yes no

If YES depth of formation _____

Why _____

Drillers Remarks: _____

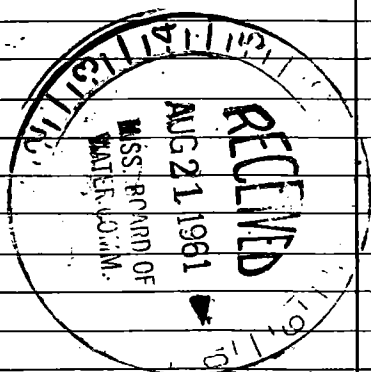

(Use Back Side)

Well No.

Handwritten text, possibly a name or title, located at the top left.

Large handwritten signature or name, possibly "Lenny".

11-14

00 00
100 100
00 00

White camp
Blue Day
Lenny

H E Baker
#30 One Roof Thompson 2012

X

Home use

3

580

Floor

13

5

7"
18"

Removal of...