

G 2007
10-27-61

WATER WELL DRILLERS LOG

Date: 10-27, 1961, Driller: Quicks & Gine County P. R.
(Name)

(1) Owner of Land: Robert Lyons
(Name)
Kiln, Miss.
(Address) SUB DIV 18 T 7 S R 4 W

(2) Location: 1/4, 1/4, Sec. 18 T 7 S R 4 W
at crossroads at Kiln
_____ miles _____ of _____
(distance) (direction) (Nearest Town)

(3) Topography: _____
(Hilly) (Flat) (Level)

(4) Purpose of Well: _____
(Domestic Irrigation
Municipal, Industrial, Other)

Description & Color of Materials Sand, Clay, Red Clay, Shell, etc.	Thick- ness Feet	Depth Feet
clay	0	10
sand	10	30
clay	30	185
sand	185	275
clay	275	315
sand	315	365
clay	365	380
sand	380	400
clay	400	420
sand	420	473

Information upon completion of well:

(1) Diameter 2 inches.

(2) Total Depth 473 feet.

(3) Water Level flowing feet below top of ground.


(4) Cased to _____, Size _____

(5) Screen: Size 2", Length 10'

(6) Were any formations sealed against pollution?
_____ yes, X no.

473

If YES depth of formation _____
Why _____
Drillers Remarks: _____

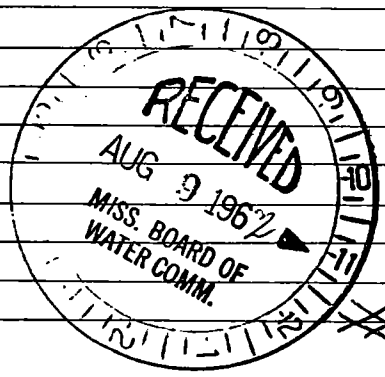

#74

Well No.

(Use Back Side)

[Faint handwritten text at the top of the page]

[Faint handwritten text in the middle section]

[Handwritten number '112' circled in a hand-drawn oval]

[Faint handwritten notes on the right side]

[Faint handwritten notes at the bottom right]

[Faint handwritten notes at the bottom left]