

HANCOCK

WATER WELL DRILLERS LOG

309

G 2009

G-309

Date: 4-3-62, 1962, Driller: Leonard Reed County Hancock

(Name)

(1) Owner of Land: Alton Jarica (Name)

1 Elm Drive (Address)

(2) Location: NW 1/4, SW 1/4, Sec. 30 T7R14

1/2 miles South of Post Office (distance) (direction) (Nearest Town)

(3) Topography: X (Hilly) (Flat) (Level)

(4) Purpose of Well: Home (Domestic Irrigation Municipal, Industrial, Other)

Description & Color of Materials Sand, Clay, Red Clay, Shell, etc.	Thick- ness Feet	Depth Feet
Clay + Mud	10	10
White sticky mud	35	45
Hard Blue Mud	20	65
Water strata	19	84

Total Depth 84 ft

Information upon completion of well:

(1) Diameter 2" x 1/4" inches.

(2) Total Depth 84 feet.

(3) Water Level S Flow, feet below top of ground.

(4) Cased to _____, Size _____.


(5) Screen: Size 1/4", Length 10'.

(6) Were any formations sealed against pollution? Back filled sand yes, no.

If YES depth of formation _____.

Why _____.

Drillers Remarks: _____.

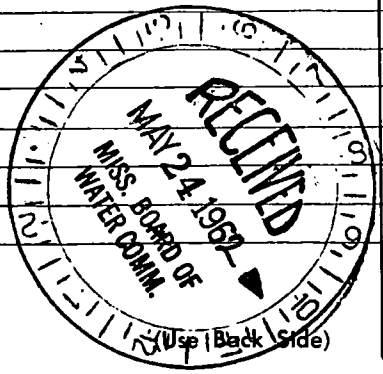

Well No.

Retain this copy for your office files.

