

G 2016

G-300

Date: 4-11-62, 1962, Driller: Lenny Beech County Hancock

Name

(1) Owner of Land: Clifford Wiza
(Name)

Rt 1 Box 166 Ross Christian
(Address)

(2) Location: SW 1/4, NW 1/4, Sec 26 T7 R14
2 1/2 miles North of Fenton
(distance) (direction) (Nearest Town)

(3) Topography: X (Hilly) (Flat) (Level)

(4) Purpose of Well: Home
(Domestic Irrigation Municipal, Industrial, Other)

Description & Color of Materials Sand, Clay, Red Clay, Shell, etc.	Thickness Feet	Depth Feet
Red Clay	25'	25'
Coarse white sand	40'	65'
White mud	65'	130'
Blue mud	35'	165'
Fine Blue sand	30'	195'
Water strata	71'	266'
Total Depth		266'

Information upon completion of well:

(1) Diameter: 2" x 1/4" inches.

(2) Total Depth: 266 feet.

(3) Water Level: 12 feet below top of ground.

(4) Cased to _____, Size _____


(5) Screen: Size 1 1/4", Length 10'

(6) Were any formations sealed against pollution?
Back filled with sand
yes, _____ no.

If YES depth of formation _____

Why _____

Drillers Remarks: _____

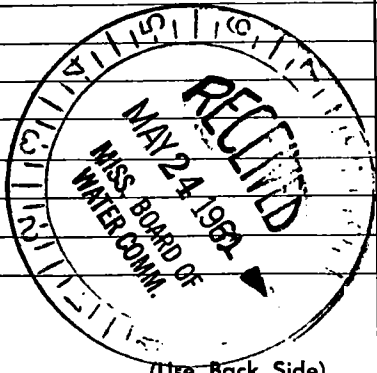

Well No.

