

G 2014
3-26-63

G

WATER WELL DRILLERS LOG

Date: 3-21, 1963, Driller: J. Bevil County: Hancock
(Name)

(1) Owner of Land: Lonee Meaise
(Name)
Rt. 1. Cars Christian
(Address)

(2) Location: AE 1/4, NW 1/4, Sec. 19 T 7 R 14
2 miles North, of Ribon
(distance) (direction) (Nearest Town)

(3) Topography: (Hilly) (Flat) (Level)

(4) Purpose of Well: Home
(Domestic Irrigation, Municipal, Industrial, Other)

Description & Color of Materials Sand, Clay, Red Clay, Shell, etc.	Thick- ness Feet	Depth Feet
<u>Red clay</u>	<u>8</u>	<u>8</u>
<u>Mud + rock</u>	<u>20</u>	<u>28</u>
<u>Hard Blue Mud</u>	<u>75</u>	<u>103</u>
<u>Strata</u>	<u>25</u>	<u>128</u>

Information upon completion of well:

(1) Diameter: 2" x 1/4" inches.

(2) Total Depth: 128 feet.

(3) Water Level: 28 feet below top of ground.


(4) Cased to _____, Size _____.

(5) Screen: Size _____, Length _____.

(6) Were any formations sealed against pollution?
_____ yes, _____ no.

Total 128 ft

If YES depth of formation _____
Why _____
Drillers Remarks: _____

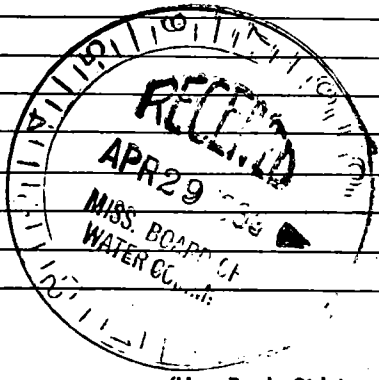

(Use Back Side)

Well No.

