

G 8815

3-27-63

WATER WELL DRILLERS LOG

G

Date 3-27, 1963, Driller: J. Beer County Hancock
 (Name)

(1) Owner of Land: Bug Holden
 (Name)
1 Elm
 (Address)

(2) Location: SW 1/4, NW 1/4, Sec. 3 T. 7 R. 14
 _____ miles _____ of _____
 (distance) (direction) (Nearest Town)

(3) Topography: _____
 (Hilly) (Flat) (Level)

(4) Purpose of Well: Home
 (Domestic Irrigation
 Municipal, Industrial, Other)

Description & Color of Materials Sand, Clay, Red Clay, Shell, etc.	Thick- ness Feet	Depth Feet
<u>Red Clay</u>	<u>8</u>	<u>8</u>
<u>White Sand</u>	<u>23</u>	<u>31</u>
<u>Soft Blue mud</u>	<u>50</u>	<u>81</u>
<u>Hard Blue Mud</u>	<u>30</u>	<u>111</u>
<u>Strata water</u>	<u>20</u>	<u>131</u>

Information upon completion of well:

(1) Diameter 2" x 1/4" inches.

(2) Total Depth 131 feet.

(3) Water Level 6ft feet below top of ground.

(4) Cased to _____, Size _____

(5) Screen: Size 1/4, Length 10ft


(6) Were any formations sealed against pollution?
Seal filled
 yes, no,

If YES depth of formation _____

Why _____

Drillers Remarks: _____

Total 131ft

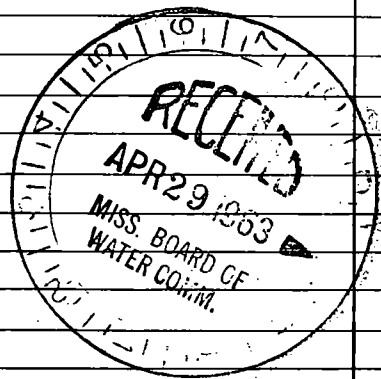

(Use Back Side)

Well No.

