

G 2019
8-22-63

WATER WELL DRILLERS LOG

G

Date: Aug 22, 1963, Driller: J. Beard County Hancock
(Name)

(1) Owner of Land Birdie Trecase
(Name)
Kilns Man
(Address)

(2) Location Lot 10 1/4, 1/4, Sec. 38 T7 R14
in miles 1/2 miles, of Kilns, of
(distance) (direction) (Nearest Town)

(3) Topography: X
(Hilly) (Flat) (Level)

(4) Purpose of Well: Home
(Domestic Irrigation
Municipal, Industrial, Other)

Description & Color of Materials Sand, Clay, Red Clay, Shell, etc.	Thick- ness Feet	Depth Feet
<u>Mud + white sand</u>	<u>42</u>	<u>42</u>
<u>Hard Blue Mud</u>	<u>134</u>	<u>176</u>
<u>Water sand</u>	<u>34</u>	<u>210</u>
<u>Total Depth 210</u>		

Information upon completion of well:

(1) Diameter 2" X 1/4" inches.

(2) Total Depth 210 feet.

(3) Water Level 12 feet below top of ground.


(4) Cased to _____, Size _____

(5) Screen: Size 1 1/4", Length 10ft

(6) Were any formations sealed against pollution?
_____ yes, _____ no.

If YES depth of formation _____
Why _____

Drillers Remarks: _____

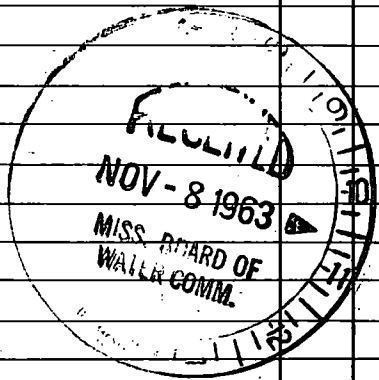

(Use Back Side)

Well No.

