

G 2020  
9-2-63

WATER WELL DRILLERS LOG

G

Date: Sept 2, 1963, Driller: J. Beck County Hancock  
(Name)

(1) Owner of Land: Roy Shigayon  
(Name)  
Paro Christian Rt 1  
(Address)  
(2) Location: DW 1/4, SW 1/4, Sec 28 T17R14  
5 miles North of Tibon  
(distance) (direction) (Nearest Town)  
(3) Topography:  (Hilly)  (Flat)  (Level)  
(4) Purpose of Well: Home  
(Domestic Irrigation  
Municipal, Industrial, Other)

| Description & Color of Materials<br>Sand, Clay, Red Clay, Shell, etc. | Thick-<br>ness<br>Feet | Depth<br>Feet |
|---|------------------------|---------------|
| <u>Red Clay</u>   | <u>18</u>              | <u>18</u>     |
| <u>Soft Clay &amp; sand</u>   | <u>60</u>              | <u>78</u>     |
| <u>soft blue mud</u>  | <u>90</u>              | <u>168</u>    |
| <u>white sand</u>   | <u>40</u>              | <u>208</u>    |
| <u>Hard Blue Till</u>   | <u>20</u>              | <u>228</u>    |
| <u>water sand</u>   | <u>23</u>              | <u>251</u>    |


Information upon completion of well:

(1) Diameter 2" x 1/4" inches.  
(2) Total Depth 251 feet.  
(3) Water Level 53 feet below top of ground.  
(4) Cased to \_\_\_\_\_, Size \_\_\_\_\_  
(5) Screen: Size 1/4, Length 10ft  
(6) Were any formations sealed against pollution?  
\_\_\_\_\_ yes, \_\_\_\_\_ no.

total depth 251ft

If YES depth of formation \_\_\_\_\_  
Why \_\_\_\_\_

Drillers Remarks: \_\_\_\_\_

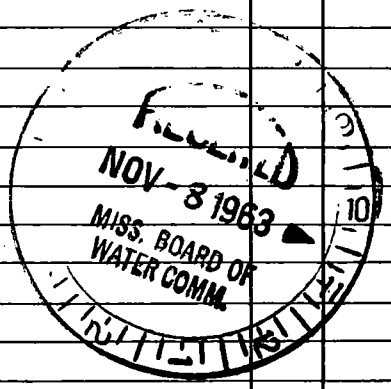

(Use Back Side)

Well No.

