


G 2023
6-17-64

WATER WELL DRILLERS LOG

G

Date: 6-17, 1964, Driller: Sutton Well Works County Hancock
(Name)

| (1) Owner of Land: | Description & Color of Materials Sand, Clay, Red Clay, Shell, etc. | Thick- ness Feet | Depth Feet |
|---|---|------------------------|---------------|
| Agnes Cuevas, Jr. (Name) | Clay | 25 | 25 |
| Rt 1 Bay St Louis Miss. (Address) | Sand | 26 | 51 |
| Location: NW 1/4, NE 1/4, Sec 30 T7S R14 W 1 miles N, of Kilw (distance) (direction) (Nearest Town) | Clay | 110 | 161 |
| (3) Topography: <u>Hilly</u> (Hilly) (Flat) (Level) | Sand | 41 | 202 |
| (4) Purpose of Well: <u>Domestic</u> (Domestic Irrigation Municipal, Industrial, Other) | | | |
| Information upon completion of well: | | | |
| (1) Diameter <u>2</u> inches. | | | |
| (2) Total Depth <u>202</u> feet. | | | |
| (3) Water Level <u>54</u> feet below top of ground. | | | |
| (4) Cased to <u>cell</u> , Size <u>2"</u> | | | |
| (5) Screen: Size <u>2"</u> , Length <u>10'</u> | | | |
| (6) Were any formations sealed against pollution? | | | |
| <input checked="" type="checkbox"/> yes, <input type="checkbox"/> no. | | | |
| If YES depth of formation <u>Surface</u> | | | |
| Why _____ | | | |
| Drillers Remarks: _____ | | | |

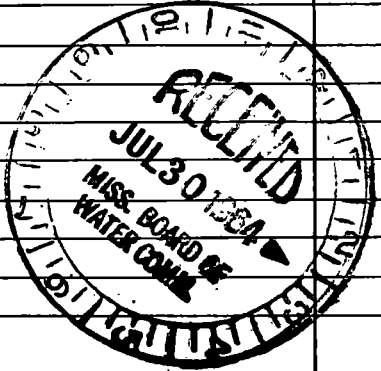

(Use Back Side)

Well No.

101 185
143 001
17 21
12 725

101 185
143 001
17 21
12 725

