

G 2099

8-13-65

WATER WELL DRILLERS LOG

Date: 8-13, 1965, Driller: Butter Weir Weir County Hancock

(Name)

(1) Owner of Land: Felix Martin
(Name)

Kiln

(Address)

(2) Location: Sub 1/4, NE 1/4, Sec. 1 P5R15W

2 miles S of Kiln
(distance) (direction) (Nearest Town)

(3) Topography: hilly
(Hilly) (Flat) (Level)

(4) Purpose of Well: domestic
(Domestic Irrigation
Municipal, Industrial, Other)

Description & Color of Materials
Sand, Clay, Red Clay, Shell, etc.

Thick-
ness
Feet

Depth
Feet

Original Well

74

Clay

16

90

Sand

20

110

Information upon completion of well:

(1) Diameter 2 inches.

(2) Total Depth 109 feet.

(3) Water Level 10 feet below top of ground.

(4) Cased to cell, Size 2"

(5) Screen: Size 2", Length 5'


(6) Were any formations sealed against pollution?

yes, no.

If YES depth of formation surface

Why

Drillers Remarks:

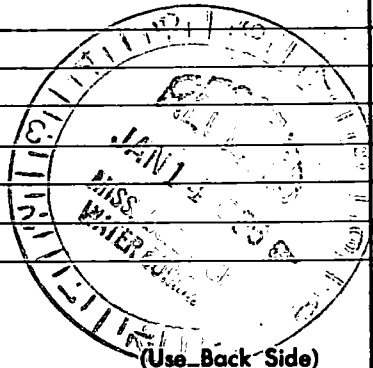

(Use Back Side)

Well No.

