

G 2034  
6-10-66

WATER WELL DRILLERS LOG

Date: June 10, 1966, Driller: L. Beck County Hancock  
(Name)

(1) Owner of Land: Don McCarrie  
(Name)  
Kilbr Miss.  
(Address)

(2) Location: S 1/4, N 1/4, Sec. 30 T 7 R 14  
\_\_\_\_\_ miles \_\_\_\_\_ of Kilbr  
(distance) (direction) (Nearest Town)

(3) Topography:  (Hilly) (Flat) (Level)

(4) Purpose of Well: Home  
(Domestic Irrigation  
Municipal, Industrial, Other)

Description & Color of Materials Sand, Clay, Red Clay, Shell, etc.	Thick- ness Feet	Depth Feet
<u>Red mud</u>	<u>42</u>	<u>42</u>
<u>fine sand</u>	<u>21</u>	<u>63</u>
<u>Blue mud</u>	<u>42</u>	<u>105</u>
<u>fine sand</u>	<u>21</u>	<u>126</u>
<u>Blue mud</u>	<u>42</u>	<u>168</u>
<u>sand strater</u>	<u>21</u>	<u>189</u>

Information upon completion of well:

(1) Diameter 2 1/4 inches.

(2) Total Depth 189 feet.

(3) Water Level 7 feet below top of ground.

(4) Cased to \_\_\_\_\_, Size \_\_\_\_\_


(5) Screen: Size 1/4, Length 10

(6) Were any formations sealed against pollution?  
\_\_\_\_\_ yes, \_\_\_\_\_ no.

If YES depth of formation \_\_\_\_\_

Why: \_\_\_\_\_

Drillers Remarks: \_\_\_\_\_

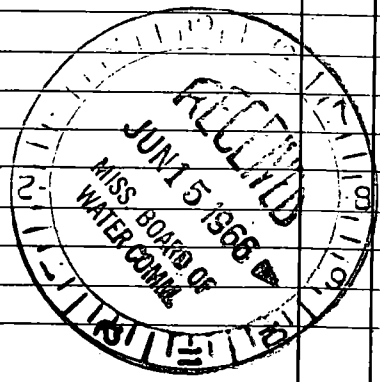

(Use Back Side)

Well No.

