

Hancock

G 2038

12-66

MISSISSIPPI BOARD OF WATER COMMISSIONERS

WATER WELL DRILLERS LOG

Date: 12-5, 1966, Driller: Walter Penitoni County Hancock

(Name)

(1) Owner of Land: Carl J. Moran (Name)

P.O. Box 155, Kiln, Miss (Address)

(2) Location: SE 1/4, NW 1/4, Sec. 17 T 7 R 14 E (Location)

2 miles N. East, of Kiln (distance) (direction) (Nearest Town)

(3) Topography: Hilly (Hilly) (Flat) (Level)

(4) Purpose of Well: Domestic (Domestic Irrigation) (Municipal, Industrial, Other)

Description & Color of Materials Sand, Clay, Red Clay, Shell, etc.

Thick-ness Foot

Depth Foot

Red Clay	24	0-24
sand	19	43
yellow clay	15	58
Blue Clay	192	250
Grey sand	22	272
Blue Clay	24	296
Grey sand	44	340
Blue Clay	125	465
Grey sand	70	535

Information upon completion of well:

(1) Diameter 4 1/2 inches. Drilled

(2) Total Depth 535 feet.

(3) Water Level 18 feet below top of ground.

(4) Cased to 515, Size 2"


(5) Screen: Size 010 2", Length 10'

(6) Were any formations sealed against pollution? yes, no.

If YES depth of formation

Why

Drillers Remarks:

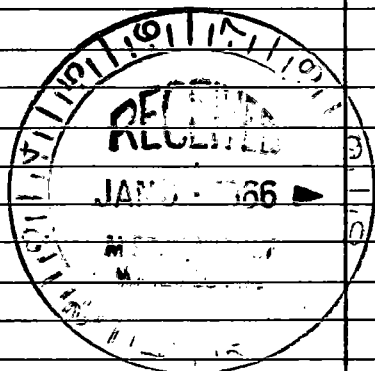

(Use Back Side)

Well No.

Handwritten text at the top of the page, possibly a title or header.

Handwritten text in the upper middle section of the page.

Handwritten text in the middle section of the page, separated by a horizontal line.

Handwritten text in the lower middle section of the page, separated by a horizontal line.

Handwritten text in the bottom section of the page.