

Hancock
 G 9039
 4-67

MISSISSIPPI
 BOARD OF WATER COMMISSIONERS
 416 North State Street
 Jackson, Mississippi 39201

WATER WELL DRILLERS LOG
 NEW LOMPkin WELL

HANCOCK
 Pearl River
 county well located

4-11
 date well completed

1967 DRILLING SERVICE
 firm name


LANDOWNER: MRS VIRGINIA
GUILBEAU Ranch
Box 539
BAY ST. LOUIS MISS.
 (mailing address)

description of formations encountered	from	to
Surface Clay	0	10
Sand	10	40
White Clay	40	80
Blue clay	80	160
good sand	160	195

WELL LOCATION:
 sec 7 T 7 S R 14 W
5 miles N of KIAN
 (distance) (direction) (nearest town)

WELL PURPOSE: HOME
 (home, irrigation, municipal, industrial)


- WELL COMPLETION DATA:
- (1) diameter (inches) 2"
 - (2) total depth (feet) 195'
 - (3) static water level (feet) 45' below above top of ground.
 - (4) casing _____ (material), _____ (depth), _____ (size) If telescope see back.
 - (5) screen 5' (length), _____ (depth to top)
2" (size), St. Steel (material)
 - (6) pump 3/4 (HP), 500g. per hr. (yield gpm)
electric (type power)
 - (7) electric log no (yes or no)
no (organization running log)
 - (8) how well bottom plugged back
pressure valve

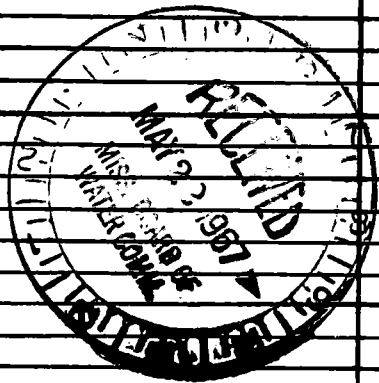

DRILLERS REMARKS:

If well telescopes please sketch and show depths.

GROUND LEVEL

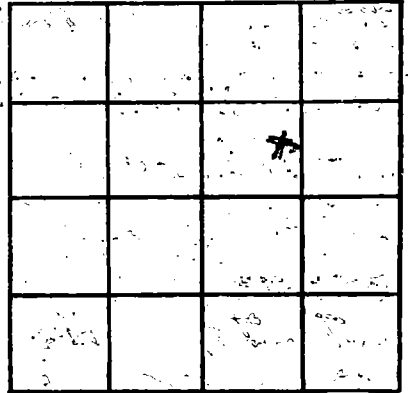

SECTION 7

Please indicate well location X.

ADDITIONAL INFORMATION

If more than one screen, show locations of each on sketch.