

Hancock
G 20410
4-67

MISSISSIPPI
BOARD OF WATER COMMISSIONERS
416 North State Street
Jackson, Mississippi 39201

WATER WELL DRILLERS LOG

4-27 1967 date well completed
Sutter Well Works firm name
Hancock county well located

LANDOWNER: MIKE LADNER

Fenton, Miss.

(mailing address)

WELL LOCATION:

sec. 23 T. 7 S. R. 14 W. of Fenton
1 miles (distance) E (direction) of (nearest town)

WELL PURPOSE: home
(home, irrigation, municipal, industrial)

WELL COMPLETION DATA:

- (1) diameter (inches) 2 1/2
- (2) total depth (feet) 654
- (3) static water level (feet) 45 below above top of ground.
- (4) casing galv steel 634'
(material) (depth)
2 1/2"
(size) If telescope see back.
- (5) screen 20' 634'
(length) (depth to top)
2 1/2" Stainless steel
(size) (material)
- (6) pump None
(HP) (yield gpm)

(type power)
- (7) electric log no
(yes or no)

(organization running log)


(8) how well bottom plugged B.P. Value

DRILLERS REMARKS:

description of formations encountered


from to

Clay	0	16
red sand	16	65
Clay	65	140
sand	140	185
Clay	185	310
sand	310	385
Clay	385	413
sand	413	610
Clay	610	618
sand	618	654

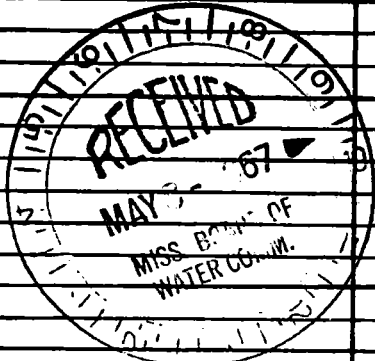

If well telescopes please sketch and show depths.

GROUND LEVEL

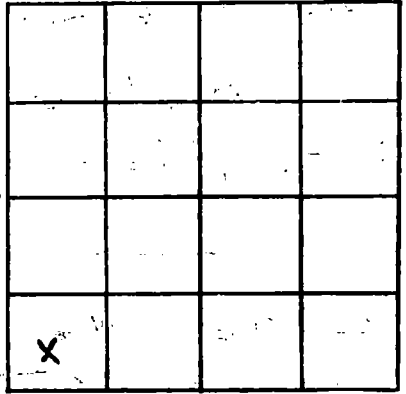

SECTION 23

Please indicate well location X.

ADDITIONAL INFORMATION

If more than one screen, show locations of each on sketch.