

~~MISSISSIPPI~~

MISSISSIPPI  
BOARD OF WATER COMMISSIONERS  
416 North State Street  
Jackson, Mississippi 39201

WATER WELL DRILLERS LOG

HANCOCK  
G-2041  
3-68

3-20 1968 date well completed  
Sutter Well Works firm name  
Hancock county well located

LANDOWNER: Arthur Marson

description of formations encountered	from to	
Clay	0	72
Sand & clay strata	72	150
Sand	150	252
Clay	252	350
Sand	350	360
Clay	360	415
Sand	415	484

Kiln

Miss  
(mailing address)

WELL LOCATION:


sec. 30 T 7 R 14 S W  
1 miles W of Kiln  
(distance) (direction) (nearest town)

WELL PURPOSE: Home  
(home, irrigation, municipal, industrial)

WELL COMPLETION DATA:

- (1) diameter (inches) 2
- (2) total depth (feet) 484
- (3) static water level (feet) 25 above top of ground.
- (4) casing Galv. 474' (material) (depth)  
2" (size) If telescope see back.
- (5) screen 10' 474' (length) (depth to top)  
2" (size) stainless steel (material)
- (6) pump none (HP) (yield gpm)  
(type power)
- (7) electric log no (yes or no)  
(organization running log)
- (8) how well bottom plugged B.P. Valve

DRILLERS REMARKS:

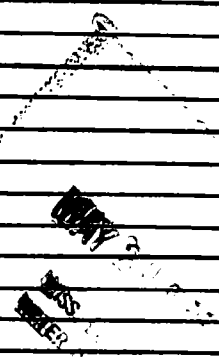

If well telescopes please sketch and show depths.

GROUND LEVEL

X			

SECTION 32

Please indicate well location X.

ADDITIONAL INFORMATION

If more than one screen, show locations of each on sketch.