

MISSISSIPPI
BOARD OF WATER COMMISSIONERS
416 North State Street
Jackson, Mississippi 39201

WATER WELL DRILLERS LOG

Hancock
A 2042
2-68

7-20 date well completed 1968 firm name Pentony Well Svc Hancock county well located

LANDOWNER: Johnny C. Banks
Rt. 1 Box 157 H
Pass Christian Miss
(mailing address)


| description of formations encountered | From | To |
|---------------------------------------|------|-----|
| Red Clay | 0 | 20 |
| Sand | 20 | 26 |
| Brown Clay | 26 | 42 |
| Blue Clay | 42 | 116 |
| Fine Sand | 116 | 177 |
| Course Sand | 177 | 187 |

WELL LOCATION:
sec. 23 T. 7 S. R. 14 W.
4 miles East of Kiln
(distance) (direction) (nearest town)

WELL PURPOSE: Home
(home, irrigation, municipal, industrial)

- WELL COMPLETION DATA:
- diameter (inches) 2"
 - total depth (feet) 187
 - static water level (feet) 20 below top of ground.
 - casing Galv. steel 182'
(material) (depth)
2" (size) if telescope see back.
 - screen 5', 182'
(length) (depth to top)
 - pump 1/2 (HP) 8 (yield gpm)
Elec (type power)
 - electric log NO (yes or no)
(organization running log)
 - how well bottom plugged B.W. Valve


DRILLERS REMARKS:

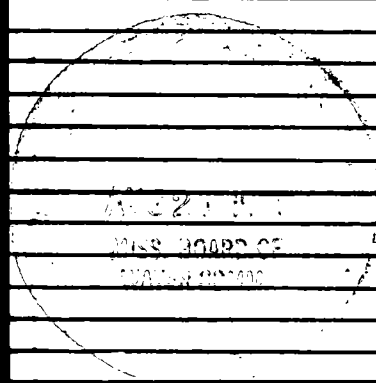

012

If well telescopes please sketch and show depths.

GROUND LEVEL

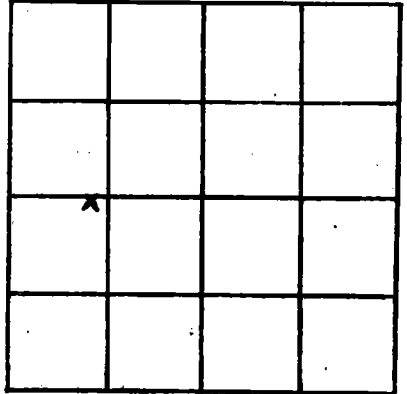

SECTION 23

Please indicate well location X.

ADDITIONAL INFORMATION

If more than one screen,
show locations of each on sketch.