


**MISSISSIPPI
BOARD OF WATER COMMISSIONERS**
416 North State Street
Jackson, Mississippi 39201

WATER WELL DRILLERS LOG

Hancock
2043
8-68

8-7 date well completed 1968 Penton Well Serv firm name Hancock county well located

LANDOWNER: <u>A. J. Necaise</u>	description of formations encountered		From	To
<u>Rt. 1 Box 163 D</u>	<u>Clay</u>		<u>0</u>	<u>68</u>
<u>Pass Christian, Miss</u> (mailing address)	<u>Sand</u>		<u>68</u>	<u>76</u>
WELL LOCATION:	<u>Brown Clay</u>		<u>76</u>	<u>85</u>
sec. <u>14</u> T- <u>7</u> S R- <u>14</u> W	<u>Blue Clay</u>		<u>85</u>	<u>120</u>
<u>4 1/2</u> miles <u>East</u> of <u>Kiln</u>	<u>Grey sand</u>		<u>120</u>	<u>153</u>
(distance) (direction) (nearest town)				
WELL PURPOSE: <u>Home</u> (home, irrigation, municipal, industrial)				
WELL COMPLETION DATA:				
(1) diameter (inches) <u>2"</u>				
(2) total depth (feet) <u>153</u>				
(3) static water level (feet) <u>28</u> below top of ground.				
(4) casing <u>Galv.</u> <u>148</u> (material) (depth)				
<u>2"</u> If telescope see back. (size)				
(5) screen <u>5'</u> <u>148</u> (length) (depth to top)				
<u>2"</u> <u>S. Steel</u> (size) (material)				
(6) pump <u>1/2</u> <u>6</u> (HP) (yield gpm)				
<u>Elec</u> (type power)				
(7) electric log <u>NO</u> (yes or no)				
(organization running log)				
(8) how well bottom plugged <u>BW. Valve</u>				

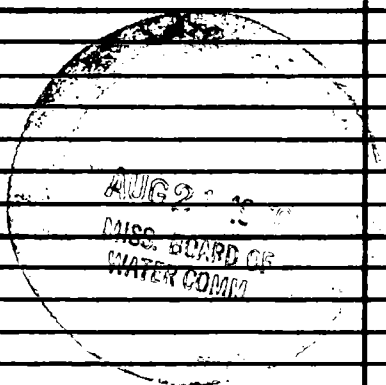

DRILLERS REMARKS:

If well telescopes please sketch and show depths.

GROUND LEVEL

X			

SECTION 14

Please indicate well location X.

ADDITIONAL INFORMATION

If more than one screen, show locations of each on sketch.