

Hancock
G 2046
8-7-75

MISSISSIPPI
 BOARD OF WATER COMMISSIONERS
 416 North State Street
 Jackson, Mississippi 39201

WATER WELL DRILLERS LOG

Aug 7 1975 Mc Hill Well Works Hancock
 date well completed firm name county well located

LANDOWNER: Klain Barriga
Rt. 3, Box 324A
Pecayne, Miss.
 (mailing address)

WELL LOCATION:
 sec 22 T 6 N R 16 E 135
18 miles NW of Kilbo
 (distance) (direction) (nearest town)

WELL PURPOSE: Home
 (home, irrigation, municipal, industrial)

WELL COMPLETION DATA:

(1) diameter (inches) 2"

(2) total depth (feet) 420'

(3) static water level (feet) 52' above
 top of ground.

(4) casing plastic, 410'
 (material) (depth)

(size) If telescope see back.

(5) screen 10', -
 (length) (depth to top)

2", 3.5
 (size) (material)

(6) pump 1 12
 (HP) (yield gpm)

electric
 (type power)

(7) electric log no
 (yes or no)

(organization running log)

(8) how well bottom plugged sand
shak


description of formations encountered	from	to
clay	0	32
sand	32	59
slush	59	73
white clay	73	108
lime sand	108	142
coarse sand	142	187
slush	187	214
blue clay	214	273
slush	273	298
lime sand	298	320
slush	320	348
blue clay	348	371
lime sand	371	390
coarse sand	390	420

NOV 22 1975
 MISS. Bd. of Water Comm

DRILLERS REMARKS:

If well telescopes please sketch and show depths.

GROUND LEVEL

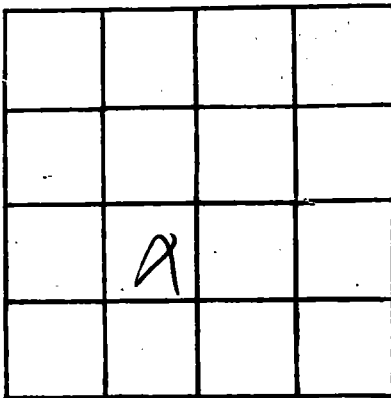

SECTION 22

Please indicate well location X.

ADDITIONAL INFORMATION

If more than one screen, show locations of each on sketch.