

Hancock
G 2048
10-2-75

MISSISSIPPI
 BOARD OF WATER COMMISSIONERS
 416 North State Street
 Jackson, Mississippi 39201

WATER WELL DRILLERS LOG

10-2- 1975 Ward Well Drilling Hancock
 date well completed firm name county well located

LANDOWNER: J.J. Purser
Rt. 1 Box 304 A
Pass Christian Miss
 (mailing address)


WELL LOCATION:
 sec. 6 T 7 N R 14 E 135
 (S) (W)
8 miles N of Hulu
 (distance) (direction) (nearest town)

WELL PURPOSE: Home
 (home, irrigation, municipal, industrial)

WELL COMPLETION DATA:
 (1) diameter (inches) 2"
 (2) total depth (feet) 280'
 (3) static water level (feet) 60 below above top of ground.
 (4) casing PVC, 270'
 (material) (depth)
 _____ If telescope see back.
 (size)
 (5) screen 10' _____
 (length) (depth to top)
2" _____
 (size) (material)
 (6) pump _____ 9
 (HP) (yield gpm)
Elec.
 (type power)
 (7) electric log _____ NO
 (yes or no)
N/A
 (organization running log)
 (8) how well bottom plugged _____ BWW

description of formations encountered	from	to
<u>top soil - clay</u>	<u>0</u>	<u>21</u>
<u>Red sd</u>	<u>21</u>	<u>36</u>
<u>Blue clay</u>	<u>36</u>	<u>87</u>
<u>sd - orange</u>	<u>87</u>	<u>115</u>
<u>clay - blue</u>	<u>115</u>	<u>165</u>
<u>sd - white</u>	<u>165</u>	<u>180</u>
<u>clay - silt</u>	<u>180</u>	<u>245</u>
<u>sd - cone</u>	<u>245</u>	<u>280</u>


DRILLERS REMARKS: N/A

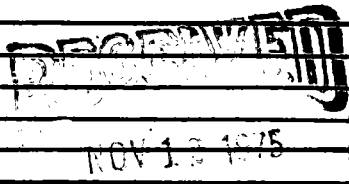

MISSISSIPPI BOARD OF WATER COMMISSIONERS

If well telescopes please sketch and show depths.

GROUND LEVEL

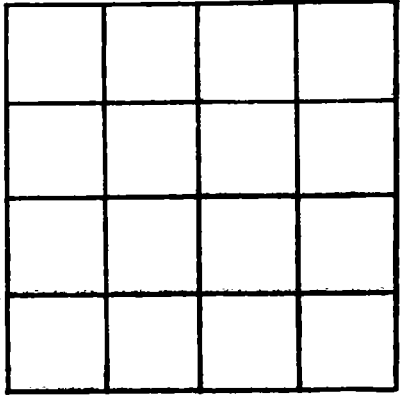

SECTION 6

Please indicate well location X.

ADDITIONAL INFORMATION

If more than one screen,
show locations of each on sketch.