

HANCOCK  
G 2052  
8/30/76

MISSISSIPPI  
 BOARD OF WATER COMMISSIONERS  
 416 North State Street  
 Jackson, Mississippi 39201

WATER WELL DRILLERS LOG

8-30 1976 Ponney Drills Hancock  
 date well completed firm name county well located

LANDOWNER: Mr. Wilson  
City Beauty Supply  
520 Broadway Dr. Hattiesburg  
 (mailing address) 39466

description of formations encountered	from	to
<u>hd-fill and clay -</u>	<u>0</u>	<u>14</u>
<u>sl - surface</u>	<u>14</u>	<u>64</u>
<u>sd - blue streaks</u>	<u>64</u>	<u>96</u>
<u>Blue Shale</u>	<u>96</u>	<u>138</u>
<u>ss -</u>	<u>138</u>	<u>176</u>

WELL LOCATION:  
 sec. 20 T. 21 N. R. 14 E  
6 miles N of City Bluffs  
 (distance) (direction) (nearest town)

WELL PURPOSE: home comp.  
 (home, irrigation, municipal, industrial)


- WELL COMPLETION DATA:
- (1) diameter (inches) 2
  - (2) total depth (feet) 165'
  - (3) static water level (feet) 5' below top of ground.
  - (4) casing PVC, 160' (material) (depth)  
2" if telescope see back. (size)
  - (5) screen 20', 160' (length) (depth to top)  
2", PVC WRAP (size) (material)
  - (6) pump 1/2, 8 (HP) (yield gpm)  
AC 115-V (type power)
  - (7) electric log — (yes or no)  
— (organization running log)
  - (8) how well bottom plugged Sealed

DRILLERS REMARKS: owner used own old pump well pumped

**RECEIVED**  
 SEP 15 1976  
 MISS. BD. OF WATER COMM.

If well telescopes please sketch and show depths.

GROUND LEVEL

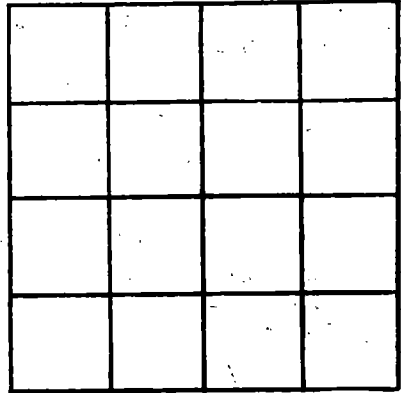

SECTION \_\_\_\_\_

Please indicate well location X.

ADDITIONAL INFORMATION

A series of 20 horizontal lines provided for entering additional information.

If more than one screen, show locations of each on sketch.