

Hancock
G 2054
9-12-76

MISSISSIPPI
 BOARD OF WATER COMMISSIONERS
 416 North State Street
 Jackson, Mississippi 39201

WATER WELL DRILLERS LOG

9-12-1976 date well completed Woodwell Drilling firm name Hancock county well located

LANDOWNER: Albert Hoda
Rt. 1, Box 322
Pass Christian, Miss.
 (mailing address)

| description of formations encountered | from | to |
|---------------------------------------|------------|------------|
| <u>Top Soil - clay</u> | <u>0</u> | <u>26</u> |
| <u>sd</u> | <u>26</u> | <u>50</u> |
| <u>clay</u> | <u>50</u> | <u>126</u> |
| <u>sd</u> | <u>126</u> | <u>148</u> |
| <u>clay - silt</u> | <u>148</u> | <u>226</u> |
| <u>sd</u> | <u>226</u> | <u>246</u> |

WELL LOCATION:
 sec. 6 T. 7 N. R. 18 E.
8 miles N of Silt
 (distance) (direction) (nearest town)

WELL PURPOSE: Home
 (home, irrigation, municipal, industrial)

- WELL COMPLETION DATA:
- (1) diameter (inches) 2
 - (2) total depth (feet) 256
 - (3) static water level (feet) 60 ^{below} above top of ground.
 - (4) casing PVC, 246,
 (material) (depth)
 (size) if telescope see back.
 - (5) screen 10', -
 (length) (depth to top)
2", PVC
 (size) (material)
 - (6) pump owner
 (HP) (yield gpm)
 (type power)
 - (7) electric log NO
 (yes or no)
N/A
 (organization running log)
 - (8) how well bottom plugged B.W.U.


DRILLERS REMARKS:

REC-10

OCT 14 1976

If well telescopes please sketch and show depths.

GROUND LEVEL

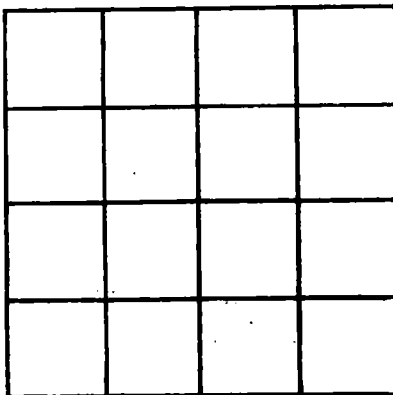

SECTION 6

Please indicate well location X.

ADDITIONAL INFORMATION

If more than one screen, show locations of each on sketch.