

HANCOCK
G JOSS
2-15-77

MISSISSIPPI
 BOARD OF WATER COMMISSIONERS
 416 North State Street
 Jackson, Mississippi 39201

WATER WELL DRILLERS LOG

2-15- 1977 Ward Well Drilling Hancock
 date well completed firm name county well located

LANDOWNER: Joe Bernard
Moran Rd.
Kiln Miss.
 (mailing address)

WELL LOCATION:
 sec. 17 T. 7 N R. 14 E
4 miles N/E of Kiln
 (distance) (direction) (nearest town)

description of formations encountered	from to	
<u>Top Soil</u>	<u>0</u>	<u>20</u>
<u>sd</u>	<u>20</u>	<u>41</u>
<u>clay-silt</u>	<u>41</u>	<u>105</u>
<u>sd</u>	<u>105</u>	<u>162</u>
<u>clay-silt</u>	<u>162</u>	<u>250</u>
<u>sd</u>	<u>250</u>	<u>296</u>
<u>clay-silt</u>	<u>296</u>	<u>485</u>
<u>sd-gravel</u>	<u>485</u>	<u>520</u>

WELL PURPOSE: Home
 (home, irrigation, municipal, industrial)

WELL COMPLETION DATA:

(1) diameter (inches) 2"

(2) total depth (feet) 520'

(3) static water level (feet) 14 ^{below} above top of ground.

(4) casing PVC 510
 (material) (depth)
 (size) If telescope see back.

(5) screen 10' -
 (length) (depth to top)
2" PVC
 (size) (material)

(6) pump 1/2 8
 (HP) (yield gpm)
Elec.
 (type power)

(7) electric log NO
 (yes or no)
N/A
 (organization running log)


(8) how well bottom plugged BWU

DRILLERS REMARKS: N/A

MAR 21 1977

If well telescopes please sketch and show depths.

GROUND LEVEL

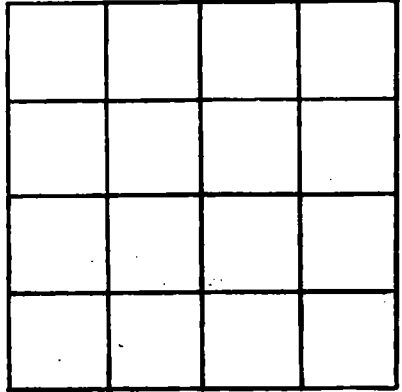

SECTION 12

Please indicate well location X.

ADDITIONAL INFORMATION

If more than one screen, show locations of each on sketch.