

HANCOCK
G 20581
7-15-77

MISSISSIPPI
 BOARD OF WATER COMMISSIONERS
 416 North State Street
 Jackson, Mississippi 39201

WATER WELL DRILLERS LOG

July 15 1977 Duncan Well Drilling Hancock
 date well completed firm name county well located

LANDOWNER: D. T. Pearson
836 Ellisville Blvd.
Laurel Miss (Well on West side of Silver Creek)
 (mailing address)

description of formations encountered	from	to
<u>TOP SAND</u>	<u>0</u>	<u>20</u>
<u>BLUE CLAY</u>	<u>20</u>	<u>160</u>
<u>FINE SAND</u>	<u>160</u>	<u>185</u>
<u>COURSE SAND</u>	<u>185</u>	<u>210</u>

WELL LOCATION:
 sec 38 T 7 N R 14 E
1 1/2 miles SE of Galva
 (distance) (direction) (nearest town)

WELL PURPOSE: Home
 (home, irrigation, municipal, industrial)


- WELL COMPLETION DATA:
- (1) diameter (inches) 2"
 - (2) total depth (feet) 210'
 - (3) static water level (feet) 6 ^{below} _{above} top of ground.
 - (4) casing PVC, 200,
 (material) (depth)
 - If telescope see back.
 (size)
 - (5) screen 10', 200
 (length) (depth to top)
 - 2", PVC SCH 40
 (size) (material)
 - (6) pump 1, 14
 (HP) (yield gpm)
 - electric
 (type power)
 - (7) electric log no
 (yes or no)
 - (organization running log)
 - (8) how well bottom plugged Sand
Shark

DRILLERS REMARKS:

RECEIVED
 OCT - 5 - 1977
 MISS. BD. OF WATER COMMISSIONERS

If well telescopes please sketch and show depths.

GROUND LEVEL

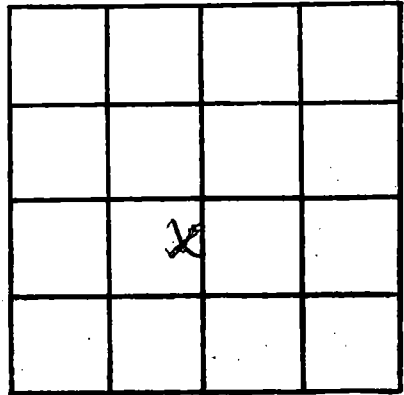

SECTION 38

Please indicate well location X.

ADDITIONAL INFORMATION

If more than one screen,
show locations of each on sketch.