

HANCOCK
 G 2059
 12/2/77

MISSISSIPPI
 BOARD OF WATER COMMISSIONERS
 416 North State Street
 Jackson, Mississippi 39201

WATER WELL DRILLERS LOG

12-2 date well completed 1977 Duncan Well Drilling Hancock firm name Hancock county well located

LANDOWNER: Ed Snow
 888 Hanao Place
 Diamond Head
 Pruitt, La. (mailing address)
 WELL LOCATION:
 sec 7 T 20N R 13E
 6 miles N of Bay St. Louis (distance) (direction) (nearest town)

description of formations encountered	depth	
	from	to
Clay	0	20
top sand	20	30
Red clay	30	120
sand	120	134
Blue clay	134	180
fine sand	180	210
Blue clay	210	260
fine sand	260	300
Course sand	300	325

WELL PURPOSE: test pump
 (home, irrigation, municipal, industrial)

WELL COMPLETION DATA:
 (1) diameter (inches) 4 1/2"
 (2) total depth (feet) 325
 (3) static water level (feet) 35' below top of ground
 (4) casing (material) PVC (depth) 325
 (size) If telescope see back.
 (5) screen 10' (length) 315 (depth to top)
 (size) PVC sch. 40 (material)
 (6) pump (HP) (yield gpm)
 (type power)
 (7) electric log (yes or no)
 (organization running log)
 (8) how well bottom plugged Sand Shark


RECEIVED
 JAN 25 1978

MISS. BD. OF WATER COMM.

DRILLERS REMARKS:
 He put gas on
 Pump in

If well telescopes please sketch and show depths.

GROUND LEVEL

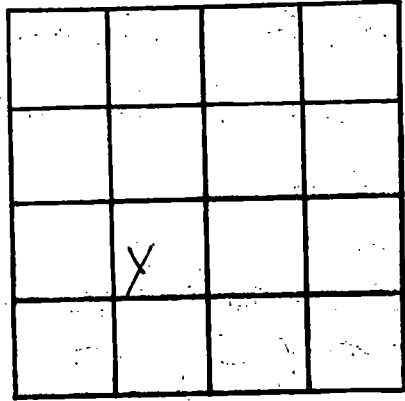

SECTION 36

Please indicate well location X.

ADDITIONAL INFORMATION

If more than one screen,
show locations of each on sketch.