

HANCOCK

G 206

5-25-78

MISSISSIPPI BOARD OF WATER COMMISSIONERS
416 North State Street
Jackson, Mississippi 39201

WATER WELL DRILLERS LOG

5-25 date well completed

1978 Woodwell Drilling firm name

hancock county well located

LANDOWNER: Rayward Lee

Hwy 603

Pass. Christian Miss.
(mailing address)

description of formations encountered

from to

<u>Top Soil - clay</u>	<u>0</u>	<u>26</u>
<u>Sandy clay</u>	<u>26</u>	<u>47</u>
<u>Fine sd</u>	<u>47</u>	<u>86</u>
<u>Coarse sd.</u>	<u>86</u>	<u>105</u>

WELL LOCATION:

sec. 19 T. 7 N. R. 14 E.
12? miles N of Bi LN
(distance) (direction) (nearest town)

WELL PURPOSE: Home
(home, irrigation, municipal, industrial)

WELL COMPLETION DATA:

- (1) diameter (inches) 2"
- (2) total depth (feet) 105
- (3) static water level (feet) 30 ^{below} _{above} top of ground.
- (4) casing PVC, 95.
(material) (depth)
If telescope see back.
(size)
- (5) screen 10, -
(length) (depth to top)
2", PVC
(size) (material)
- (6) pump owner
(HP) (yield-gpm)
(type power)
- (7) electric log no
(yes or no)
N/A
(organization running log)
- (8) how well bottom plugged BWV


DRILLERS REMARKS: N/A

REGISTERED JUN 28 1978

MISS. BD. OF WATER COMM

If well telescopes please sketch and show depths.

GROUND LEVEL

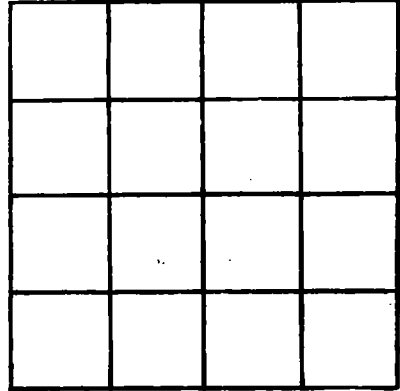

SECTION 19

Please indicate well location X.

ADDITIONAL INFORMATION

If more than one screen, show locations of each on sketch.