

HANCOCK
G 7064
7-12-78

MISSISSIPPI
BOARD OF WATER COMMISSIONERS
416 North State Street
Jackson, Mississippi 39201

WATER WELL DRILLERS LOG

July 12 1978 Buncan Well Drilling Hancock
date well completed firm name county well located


LANDOWNER:	description of formations encountered	from	to
184 Lanai Village	Top Sand	0	75
Bay St. Louis, Ms.	Blue Clay	75	200
(mailing address)	Fine Sand	200	310
WELL LOCATION:	Blue Clay	310	450
sec 35 T 7 N R 14 E	Fine Sand	450	500
0.8 miles NW of Bay St. Louis	Coarse Sand	500	546
(distance) (direction) (nearest town)			
WELL PURPOSE: Home			
(home, irrigation, municipal, industrial)			
WELL COMPLETION DATA:			
(1) diameter (inches) 2" x 4"			
(2) total depth (feet) 546			
(3) static water level (feet) 20' below top of ground			
(4) casing PVC 5.36' (material) (depth)			
(5) screen 10' 5.36' (size) (length) (depth to top)			
2" PVC sch. 40 (size) (material)			
(6) pump 1 sub. 20 (HP) (yield gpm)			
electric (type power)			
(7) electric log No (yes or no)			
(organization running log)			
(8) how well bottom plugged Sand			
Shark			
DRILLERS REMARKS:			

RECEIVED
AUG 11 1978

MISS. BD. OF WATER COMM

If well telescopes please
sketch and show depths.

GROUND LEVEL

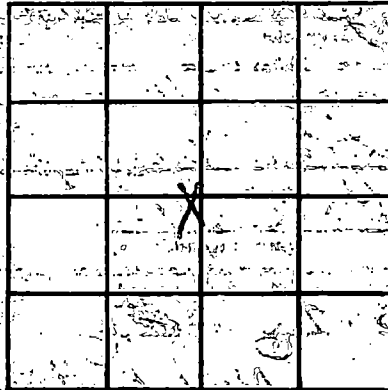

SECTION 35

Please indicate well location X.

ADDITIONAL INFORMATION

If more than one screen,
show locations of each on sketch.