

HANCOCK

G 2068

12-02-78

MISSISSIPPI BOARD OF WATER COMMISSIONERS
416 North State Street
Jackson, Mississippi 39201

WATER WELL DRILLERS LOG

12-2-1978
date well completed

28 Wardwell Dr.
firm name

Hancock
county well located

LANDOWNER Dewey Hodak Jr.
Rt. 1, Box 354
Pass Christian, Miss
(mailing address)


description of formations encountered	from	to
top soil - clay	0	22
orange sd clay	22	66
clay - silt	66	255
sd	255	312
clay	312	510
loam sd	510	546

WELL LOCATION:
sec 35 T 7 N R 14 E
12 miles N/E of Kiln
(distance) (direction) (nearest town)

WELL PURPOSE: Home
(home, irrigation, municipal, industrial)

- WELL COMPLETION DATA:
- (1) diameter (inches) 2"
 - (2) total depth (feet) 546
 - (3) static water level (feet) 36 below top of ground
 - (4) casing PVC, 536 (material) (depth)
 - (5) screen 10' (length), (depth to top)
2" PVC (size) (material)
 - (6) pump 1 (HP), 12 (yield gpm)
Elec. (type power)
 - (7) electric log NO (yes or no)
N/A (organization running log)
 - (8) how well bottom plugged BWL

DRILLERS REMARKS: N/A

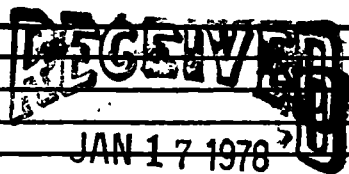

MISS. BD. OF WATER COMM. COMM

