

HANCOCK

G 2278

10/07/78

MISSISSIPPI BOARD OF WATER COMMISSIONERS
416 North State Street
Jackson, Mississippi 39201

WATER WELL DRILLERS LOG

Oct. 7 - 1978 date well completed
Mottel Well Drains firm name
Hancock county well located

LANDOWNER: Tommy Pavolosi

Delite - Kiln Rd.

Alan Christman

(mailing address)

WELL LOCATION:

sec. 11 T. 7 N. R. 14 E.
1 1/2 miles N of Delite Creek
(distance) (direction) (nearest town)

WELL PURPOSE: none
(home, irrigation, municipal, industrial)

WELL COMPLETION DATA:

- (1) diameter (inches) 2"
- (2) total depth (feet) 400 ft
- (3) static water level (feet) 45' below top of ground.
- (4) casing 40' 390'
(material) (depth)
- (size) if telescope see back.
- (5) screen 10' -
(length) (depth to top)
- 2' plastic
(size) (material)
- (6) pump 1 15
(HP) (yield gpm)
- electric
(type power)
- (7) electric log no
(yes or no)
- (organization running log)
- (8) how well bottom plugged Sand
mark

description of formations encountered

from to

clay	0	68
s. sand	68	94
slush	94	138
w. clay	138	187
s. clay	187	243
s. sand	243	292
blue clay	292	361
s. sand	361	400

Miss. Board of Water Comm.


AUG 27 1978

RECEIVED

DRILLERS REMARKS:

If well telescopes please sketch and show depths.

GROUND LEVEL

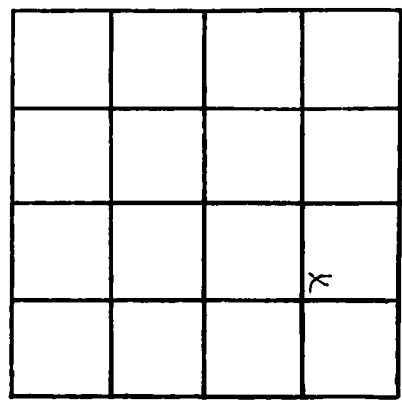

SECTION 11

Please indicate well location X.

ADDITIONAL INFORMATION

Lined area for additional information.

If more than one screen, show locations of each on sketch.